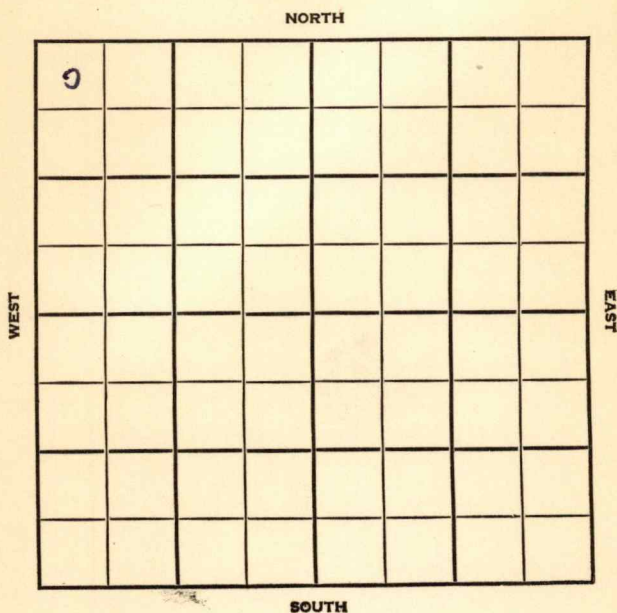


Section 26 Township 28 Range 7EWell No. 3 RempCompany White & Ellis

SEC.		TWP.		R.	
26		Butler 28		KANSAS 7E ✓	
WELL NO.					
3 Remp				FARM	
COMPANY					
White & Ellis					
CONTRACTOR					

330		Ft. from N. Line	WEST NORTH SOUTH EAST
		Ft. from S. Line	
		Ft. from E. Line	
330		Ft. from W. Line	

NW NW NW		
1954	ELEVATION 1553	REPORT

6/2	8" @ 99
	Drlg. 2001
6/23	Spudding 5-29-54
	Oil well
	TD 2477
	8" @ 99
	Lans. 1745 KC 2083 Peru 2452
	TD 2471
	4" @ 2464
	DD 2477 PB 2471
	frac Comp. 10 bopd 15 bw

COMPLETED

County **Butler** State **Kansas**

Sec. **26** (Blk.) **28** (Sur.) **7E** Map No.

Operator **White & Ellis**

Well No. **3** Farm **Remp**

Elev. Location **NW NW NW**

0							
FIRST REPORT							

330Ft. From **N** Line **NW**

330Ft. From **W** Line Quarter

1st. Report **JUN 2 1954**

Completion

Remarks

Spudding Date **5-29-54**

Drlg. Data **Semisch Pool**

8" @ 99 drlg. 2001

J. G. McGEHEE

County Butler State KansasSec. 26 (Blk.) 28 (Sur.) 7E Map No.Operator White & EllisWell No. 3 Farm RempElev. 1553 Location NW NW NW

0					

330 Ft. From N Line NW330 Ft. From W Line Quarter

1st. Report

JUN 23 1954

Completion

Remarks Semisch PoolSpudding Date 5-29-54Drlg. Data Oil well TD 24778" @ 99 Lans. 1745 KC 2083 Peru 2452TD 2471 4" @ 2464 DD 2477 PB 2471frac Comp. 10 bopd 15 bw

J. G. McGEHEE