


Butler

KANSAS

SECTION 27 TOWNSHIP 28S RANGE 7E

WELL NO. #1 Cook

COMPANY Bedell & Catt

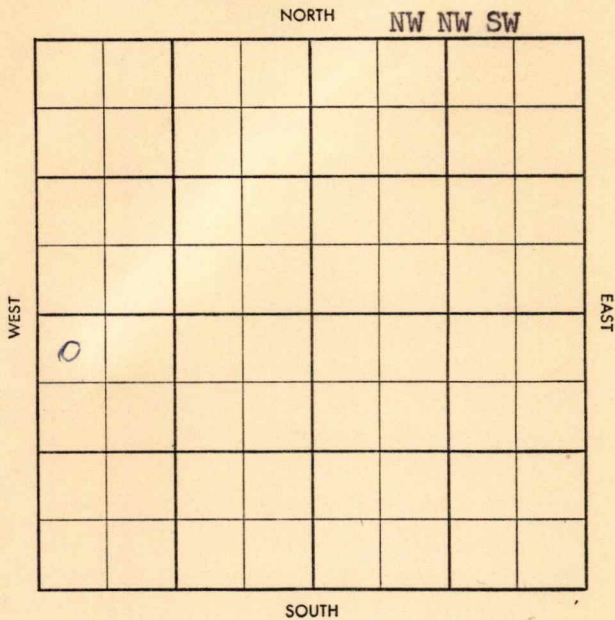

Twp. ~~XXXXXX~~ Pool ~~XXXXXX~~

Co. ~~XXXXXX~~ Facet ~~XXXXXX~~

S-513-B

County Butler Elev. _____
 Sec. 27 Twp. 28 Rge. 7E
 Company Bedell & Catt
 Farm Name Cook No. 1

| TOPS | DEPTH | LOG | DATUM |
|--------|-------|-----|-------|
| Anh. | | | |
| Tp. | | | |
| H. | | | |
| Tr. | | | |
| Dg. | | | |
| B.L. | | | |
| L. | | | |
| K.C. | | | |
| B.K.C. | | | |
| Ce. | | | |
| C. | | | |
| M. | | | |
| M. | | | |
| K. | | | |
| Mz. | | | |
| Mq. | | | |
| V. | | | |
| S. | | | |
| S. | | | |
| A. | | | |
| R. | | | |
| Pf. | | | |
| G. | | | |
| T.D. | | | |

Loc. in Sec. NW NW SW
 Geol. _____
 Contr. Geahhart
Canady tools
 Pool Brandt
Sensenbaugh



Date Comm. to start by 7/1

Co.
Lse.
No.
Sec.
T.
R.

Twp. ~~X~~ Pool ~~X~~
 Co. ~~X~~ Facet ~~X~~

S-513.B

County Butler Elev. 15330 of 153698
 Sec. 27 Twp. 28 Rge. 7E
 Company Bedell & Catt
 Farm Name Cook No. 1

| TOPS | DEPTH | LOG | DATUM |
|----------------|-------------|-----|-------|
| Anh. | | | |
| Tp. | | | |
| H. | | | |
| Tr. | | | |
| Dg. | | | |
| B.L. | | | |
| L. | | | |
| K.C. | <u>2078</u> | | |
| B.K.C. | <u>2249</u> | | |
| Ce. <u>max</u> | <u>2352</u> | | |
| C. <u>peru</u> | <u>2429</u> | | |
| M. <u>Li</u> | <u>2859</u> | | |
| M. | | | |
| K. | | | |
| Mz. | | | |
| Mq. | | | |
| V. | | | |
| S. | | | |
| S. | | | |
| A. | | | |
| R. | | | |
| Pf. | | | |
| G. | | | |
| T.D. | <u>2910</u> | | |

Loc. in Sec. NW NW SW
 Geol. _____
 Contr. Gearhart
Canady tools
 Pool Brandt-
Sensenbaugh

ABANDONED
 JUL 23 '58

Date Comm. 7-6-58 8" 132/125
 to start by 7/1 JUN 11 '58 JUN 18 '58 JUN 25 '58 JUL 2 '58

JUL 9 '58 2450 DST 186 2205 1hr
5' M BHP 0-60 FP 0-0 DST
2426-50 JUL 19 '58 op 10" 150' M
I BHP 1085 1/2" fish 2750
JUL 23 '58 DST 2425 -50 1hr 20' M
120 S salt cm spk oil BHP
675/30 FP 90-100 no log
D 6A

Co.
Lse.
No.
Sec.
T.
R.