

Section 29 Township 28 Range 7 E

Well No. # 1 Ramp

Company Wilson Raines & Williamson

NORTH

0							

WEST

EAST

SOUTH

Butler

KANSAS

SEC.	TWP.	R.
29	28	7 E


WELL NO. # 1 Ramp FARM

COMPANY Wilson Raines & Williamson

CONTRACTOR Bedell & Catt

Wildcat

330 _____ Ft. from N. Line
 _____ Ft. from S. Line
 _____ Ft. from E. Line
 330 _____ Ft. from W. Line

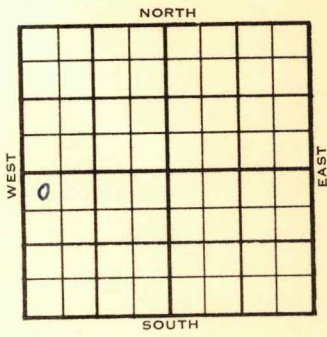

NW NW SW

1954	ELEVATION 1502 1498'	REPORT
------	------------------------------------	--------

12/15	Spud 12-8-54 KC 2126 Miss. 2824' Drlg. 2850'
12/22	Spud 12-8-54 D & A TD 2878 Oread 1450 Doug 1535 Br lime 1746 Lans. 1809 KC 1977 Marm. 2398 Ft. Scott 2524 Cherokee 2570 Miss 2826 TD 2878 D & A

ABANDONED

