

KANSAS

Woodson ✓

Section 20 Township 25 Range 14-E

Well No. #18 Klick

Company Sheedy etal

Misc.

NORTH

WEST

EAST

						0	

SOUTH

Sec. 20 Twp. 25 R. 1/E

Well No. 18 Klick Farm

Sheedy et al Company

Misc.


990 Ft. from N. Line

_____ Ft. from S. Line

990 Ft. from E. Line

_____ Ft. from W. Line

SW NE SE

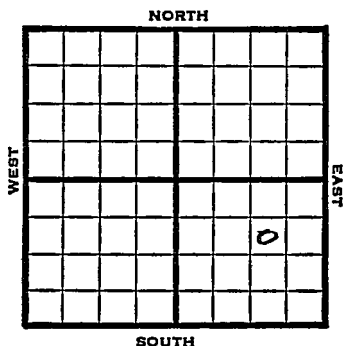

1949 REPORT

1949	
7/27	12" @ 140 10" @ 640 750
8/3	7" @ 1399' Bart 1403' Drlg. 1408'
8/10	TD 1433 CO
8/16	"
8/24	"
8/31	"
9/7	"
9/14	TD 1433' Bart 1403' 7" @ 1399' Pump 10 Oil Pot 36° Gr. Comp
	COMPLETED

Kansas

Map No. _____ Sec. 20 Twp. 25 R. 14E

Well No. 18 Klick

Sheedy et al. _____ Company

Contractor

SW NE SE

FIRST REPORT
SECTION PLAT

990 _____ Ft. from N. Line

_____ Ft. from S. Line

990 _____ Ft. from E. Line

_____ Ft. from W. Line

			o

Woodson County

Location _____

Rig up _____

Drilling and Remarks:

12 " @ 140

10" @ 640

750

RECORD

Cased _____ in., _____ ft.

Sand _____

Gas _____

Oil _____

Total Depth _____

PRODUCTION

1st 24 hrs. Nat. _____

1st 24 hrs. after shot _____

Gas _____ Cu. Ft.

Dry Hole _____

Abandoned _____

Date

JUL 27 1949 19

S. J. LEWIS Scout

