


Map No. Kansas Sec. 30 Twp. 28 R. 7
 Well No. 1 Jones Farm
John Herron Company

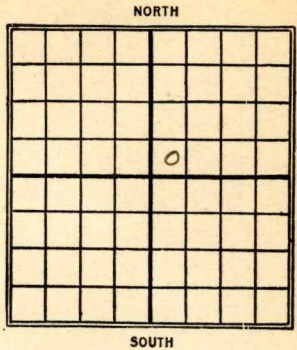

..... Ft. from N. Line

330 Ft. from S. Line

..... Ft. from E. Line

330 Ft. from W. Line

Date	REPORT
1926	
6/2	Location
6/10	timbers
6/18	_____
6/25	_____
6-30	Ry
7/8	Rig & tools
7/15	_____
7/22	_____
7/28	Dlq 775
8/4	Dlq 1090
8/11	running 10" 1332
8/18	fighting cave 1610
8/25	Drlq 2175
8/31	" 2176
9/15	" 2522
9/22	S.D. 2802' for 6"
9/29	lime shell 2810-18'
	sdy lime 2818-25'
	showing of oil
10/13	J.D. 2855 swabbing
	all water
10/27	Plugged back to 2827'
	Pumped 25 bbl oil & lots water

11/11 - J.D. 2839' S.L.M. P.B. to
2831' pumped 70 bbls
oil + 70 bbls water

11/17 - Sand 2818-2824
T.D. 2839 P.B. 2831
20 bbls oil
70 bbls water

K10 KANSAS *Butter*
Map No. _____ Sec. *30* Twp. *28* R. *7*

Well No. *1*
Jones
John Haxon Company

Contractor _____

FIRST REPORTS

SECTION PLAT

_____ Ft. from N. Line

330 _____ Ft. from S. Line

_____ Ft. from E. Line

330 _____ Ft. from W. Line

		o	

Location *✓* _____

Rig up _____

Drilling and Remarks:

RECORD

Cased _____ in., _____ ft.

Sand _____

Gas _____

Oil _____

Total Depth _____

PRODUCTION

1st 24 hrs. Nat. _____

1st 24 hrs. after shot _____

Gas _____ Cu. Ft.

Dry Hole _____

Abandoned _____

Date

JUN 2 1926

_____ 192 _____ Scout

CHAS. L. SHERWOOD

Butler

Map No. 10 KANSAS Sec. 30 Twp. 28 R. 7

Well No. John Jones
John Hevon Company

Contractor

COMPLETED

SECTION PLAT

Ft. from N. Line

330

Ft. from S. Line

Ft. from E. Line

330

Ft. from W. Line

		o	

Location

Rig up

Drilling and Remarks:

Slugged back to

2831'
20 lbs oil
70 " water.

RECORD

Cased 2818-24 in., ft.

Sand

Gas

Oil

Total Depth 2839

PRODUCTION

1st 24 hrs. Nat.

1st 24 hrs. after shot

Gas Cu. Ft.

Dry Hole

Abandoned

Date

NOV 17 1926

192

CHAS. L. SHERWOOD

Scout