

Sec. 33 Twp. 28 R. 7E

Well No. 1 - Peak

1 No. 1000
Mid-Kansas Cor

9

WEST

EAST

SOUTH

Rig Up.....

Drilling Remarks

PRODUCTION

1st 24 hrs. Nat.

1st 24 hrs. after shot.....

Gas..... cu. ft.

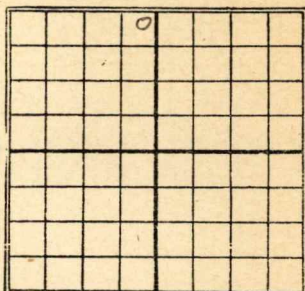
Dry Hole

Abandoned

Butler

Map No. Kansas Sec. 33 Twp. 28 R. 7^EWell No. 1 Peak FarmMid-Kansas Company

NORTH

330 Ft. from N. Line

Ft. from S. Line

330 Ft. from E. Line

Ft. from W. Line

Date
1927

REPORT

1/19	Bldg Rig
1/26	Rigging up
2/3	Drlg - 400
2/10	" 800
2/17	" 1750
2/24	" 1535
3/2	UR. 1645
3/9	Drlg 2075
3/16	" 2560
3/24	Sand 2692-95 - Dry top line 2823 - 1st break 2885 - small show oil Drilling 2925
5/30	Sand 2692-95 - dry Top line 2823 1st bk 2885' small show Wilcox 3245-50' D. & G. 3261-H F W

10 **KANSAS** 33 28 7^e
 Map No. _____ Sec. _____ Twp. _____ R. _____
 Well No. 1 *Peak* _____

Mid-Kansas _____ Company _____

_____ Contractor _____

FIRST REPORTS

SECTION PLAT

330 _____ Ft. from N. Line

_____ Ft. from S. Line

330 _____ Ft. from E. Line

_____ Ft. from W. Line

	0		

Location _____

Rig up *Blog reg* _____

Drilling and Remarks:

RECORD

Cased _____ in., _____ ft.

Sand _____

Gas _____

Oil _____

Total Depth _____

PRODUCTION

1st 24 hrs. Nat. _____

1st 24 hrs. after shot _____

Gas _____ Cu. Ft.

Dry Hole _____

Abandoned _____

Date

JAN 19 1927

_____ 192 _____ Scout

CHAS. L. SHERWOOD

10 **KANSAS** 33 28 7
 Map No. Sec. Twp. R.
 Well No. 1 *Hear*

Mid-Kansas Company

Contractor

COMPLETED

SECTION PLAT

330 Ft. from N. Line

Ft. from S. Line

330 Ft. from E. Line

Ft. from W. Line

ABANDONED

	0		

Location

Rig up

Drilling and Remarks:

And 2692-95 Dry
Top line 2823
1st Big 2885 Small
Show oil.
Wilcox 3245-50
204 3261 HFW

RECORD

Cased in., ft.

Sand

Gas

Oil

Total Depth *3261*

PRODUCTION

1st 24 hrs. Nat.

1st 24 hrs. after shot

Gas Cu. Ft.

Dry Hole ☒

Abandoned ☒

Date

MAR 30 1927

192

CHAS. L. SHERWOOD

Scout