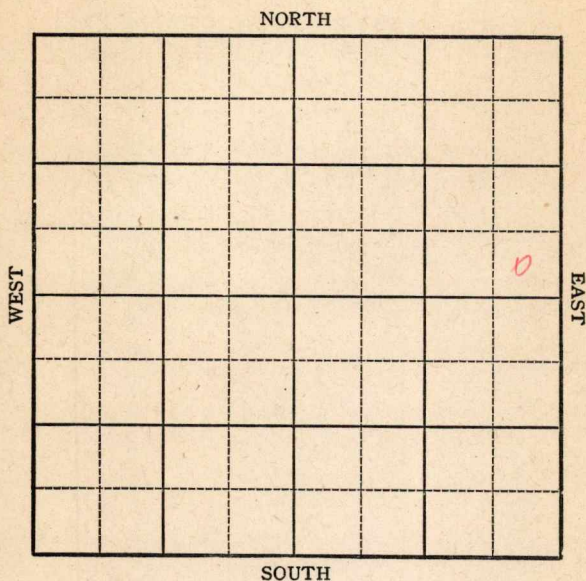


KANSAS

Butler

Section 33 Township 28 Range 7EWell No. 1 StarkeyCompany Skelly

KANSAS

Butler

Sec. 33 Twp. 28 R. 7E

Well No. 1 Starkey Farm

Skelly Company

Miscellaneous

Ft. from N. Line


330

Ft. from S. Line

330

Ft. from E. Line

Ft. from W. Line

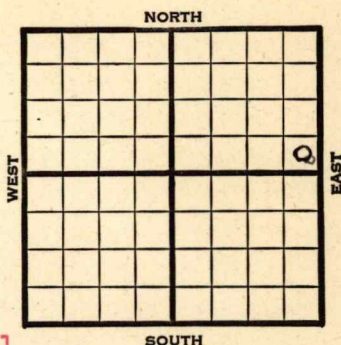

SE NE

Elev. 1511

SOUTH

1945

REPORT

4/25	Location
5/3	"
5/10	Drlg. 725
5/17	12" @ 872
	Drlg. 940'
5/24	1463 UR 10"
5/31	1565' UR 10"
6/13	Miss 2820
	HPW
	TD 2859'

ABANDONED

Kansas Pool Name MiscellaneousMap No. 10 Sec. 33 Twp. 28 R. 7EWell No. 1 StarkeySkelly


Company

FIRST REPORT

Contractor

SE NE

SECTION PLAT

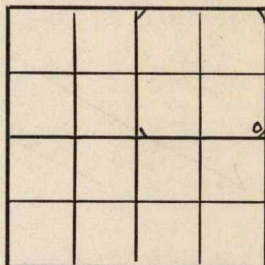 Ft. from N. Line330 Ft. from S. Line330 Ft. from E. Line Ft. from W. Line

Butler

Location XRig up

Drilling and Remarks:

RECORD

Cased in., ft.Sand Gas Oil Total Depth

PRODUCTION

1st 24 hrs. Nat. 1st 24 hrs. after shot Gas Cu. Ft.Dry Hole Abandoned

Date

APR 25 194519S. J. LEWISScout

Kansas Pool Name MiscellaneousMap No. 10 Sec. 33 Twp. 28 R. 7EWell No. 1 StarkeySkelly Company**ABANDONED**

SE NE

21, 1511
SECTION PLAT

			6

 Ft. from N. Line330 Ft. from S. Line330 Ft. from E. Line Ft. from W. Line

Butler County

Location Rig up

Drilling and Remarks:

Mies 2828XFW**RECORD**Cased in., ft.Sand Gas Oil Total Depth 2839**PRODUCTION**1st 24 hrs. Nat. 1st 24 hrs. after shot Gas Cu. Ft.Dry Hole Abandoned

Date

JUN 13 1945 19S. J. LEWIS Scout