


Section 35 Township 28 Range 7E

Well No. 1 Benedict

Company White & Ellis & Fred Ayesch

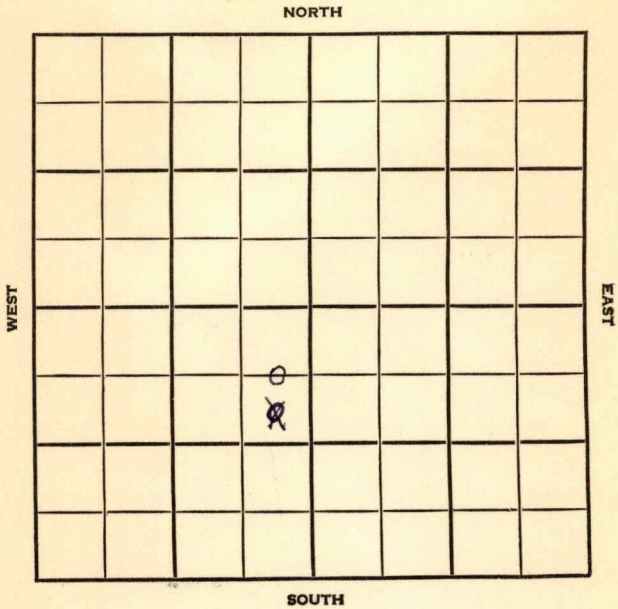

Butler

KANSAS

SEC.	TWP.	R.
35	28	7 E ✓

WELL NO. # 1 Benedict FARM

COMPANY

CONTRACTOR White & Ellis & Fred Ayesch


White & Ellis  
Wildcat

~~990~~ 660 Ft. from N. Line

\_\_\_\_\_ Ft. from S. Line

330 Ft. from E. Line

\_\_\_\_\_ Ft. from W. Line

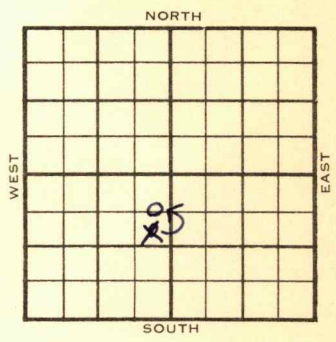

CEL  
~~SE~~ NE SW

	ELEVATION	REPORT
1954	1547'	

4/27 Spud 4-23-54  
8" @

Drlg. 1912'

5/19 Spud 4-23-54  
8" @

KC 2094', Peru 2448'

TD 2515'

D & A

**ABANDONED**


County Butler State Kansas

Sec. 35 (Blk. 28 (Sur. 7E (Twp. 7E Map No.

Operator White & Ellis & Fred Ayesch

Well No. 1 Farm Benedict

Elev. \_\_\_\_\_ Location SE NE SW

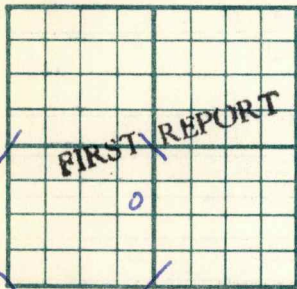

990 Ft. From N Line SW

330 Ft. From E Line Quarter

Ist. Report APR 27 1954

Completion \_\_\_\_\_

Remarks \_\_\_\_\_

White & Ellis - Contr.

Spudding Date 4-23-54

Drlg. Data Wildcat

8" @ drlg. 1912

J. G. MCGEHEE

Map No. \_\_\_\_\_ Sec. 35 Twp. 28 R. 7E

Well No. 1 Benedict

White & Ellis & Fred Ayesch Company

**CORRECTION**

Contractor

C E L NE SW


**SECTION PLAT**

660 Ft. from N. Line

\_\_\_\_\_ Ft. from S. Line

330 Ft. from E. Line

\_\_\_\_\_ Ft. from W. Line

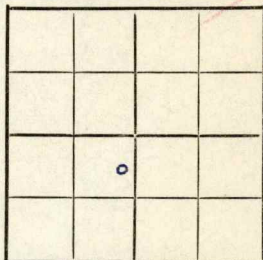

Butler County

Location \_\_\_\_\_

Rig up \_\_\_\_\_

Drilling and Remarks:

Reported  
SE NE SW

**RECORD**

Cased \_\_\_\_\_ in., \_\_\_\_\_ ft.

Sand \_\_\_\_\_

Gas \_\_\_\_\_

Oil \_\_\_\_\_

Total Depth \_\_\_\_\_

**PRODUCTION**

1st 24 hrs. Nat. \_\_\_\_\_

1st 24 hrs. after shot \_\_\_\_\_


Gas \_\_\_\_\_ Cu. Ft.

Dry Hole \_\_\_\_\_

Abandoned \_\_\_\_\_

Date \_\_\_\_\_

County Butler State Kansas  
 Sec. 35 (Blk.) 28 (Sur.) 7E Map No.  
 Operator White & Ellis & Fred Ayesch  
 Well No. 1 Farm Benedict  
 Elev. 1547 Location C E L N E SW

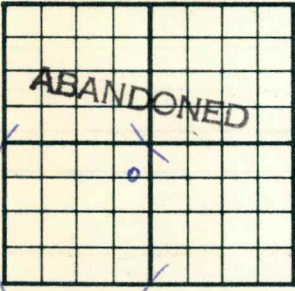

660 Ft. From N Line SW  
330 Ft. From E Line Quarter  
 Ist. Report \_\_\_\_\_  
 Completion MAY 19 1954  
 Remarks Wildcat  
White & Ellis - Contr.  
 Spudding Date 4-23-54

Drlg. Data  
8" @ KC 2094 Peru 2448 TD 2515  
D & A

J. G. McGEHEE