

KANSAS

Section 6 Township 16 Range 12-WWell No. #8 DepisseCompany Franco Central & Gore

NORTH

WEST

						0	

EAST

SOUTH

Barton KANSAS

Sec. 6 Twp. 16 R. 12W

Well No. #8 Depisse Farm

Franco Central & Gore Company

Wakefield - Contr. Contractor

Beaver Pool


330' Ft. from N. Line

Ft. from S. Line

990' Ft. from E. Line

Ft. from W. Line

NW NE SE

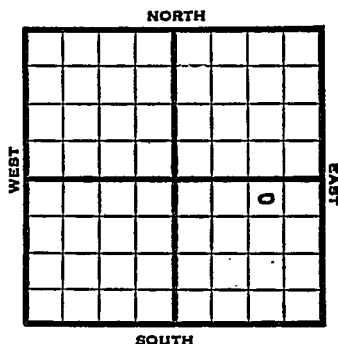

1951 Elev. 1859' REPORT

1/10 Spud. 1-4-51

Drlg. 410'

3/14 Spud 1-4-51

Oil Well TD 3301

13" @ 410' 10" @ 797

8" @ 2435

Top. 2657 SSO 2805-12

7" @ 2910 Dodge 2966

Br Lime 3025 Lans. 3042

B/1 boph @ 3048-51 300' water @ 3117-35 SO 3178-82

Cong. 3291-95 Arb. 3295-99

5" @ 3296 TD 3301 FU 2000'


oil 10 hr SP 3210 24/3185-3231

3000 A water & SSO 24/3041-47

1000 A S/3 boph Comp. 75 bopd

COMPLETED

J. E. TYRA

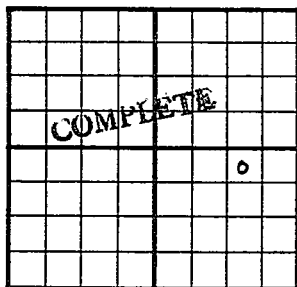County Barton State KansasSec. 6 (Blk. Twp.) 16 (Sur. Rge.) 12W Map No.Operator Franco Central & GoreWell No. 8 Farm DepisseElev. 1859 Location NW NE SE330 Ft. From N Line SE990 Ft. From E Line Quarter1st. ReportCompletion MAR 14 1951Remarks Beaver PoolWakefield - Contr.Spudding Date 1-4-51Drlg. Data Oil well TD 330113" @ 410 10" @ 797 8" @ 2435Top. 2657 SSO 2805-12 7" @ 2910Dodge 2966 Br. lime 3025 Lans. 3042B/ 1 boph @ 3048-51 300' water @ 3117-35SO 3178-82 Cong. 3291-95 Arb. 3295-995" @ 3296 TD 3301 FU 2000' oil 10 hr.SP 3210 24/ 3185-3231 3000 Awater & SSO 24/ 3041-47 1000 AS/ 3 boph Comp. 75 bopd

J. E. TYRA