


Section 6 Township 16 Range 12W

Well No. 2 Staudinger "B"

Company Phil-Han

Kraft-Prusa Pool  
NORTH

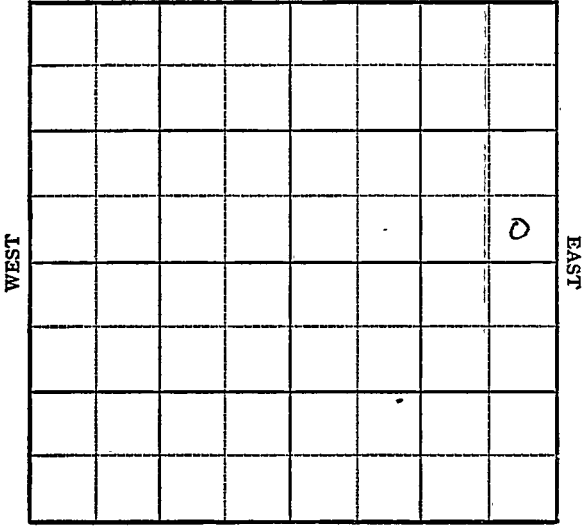

, SOUTH

KANSAS

Barton

Sec. 6 Twp. 16 R. 12W

Well No. #2 Staudinger "B" Farm

Phil-Hen Company

**Kraft-Prusa Pool**


\_\_\_\_\_ Ft. from N. Line

330' Ft. from S. Line

330' Ft. from E. Line

\_\_\_\_\_ Ft. from W. Line

SE NE

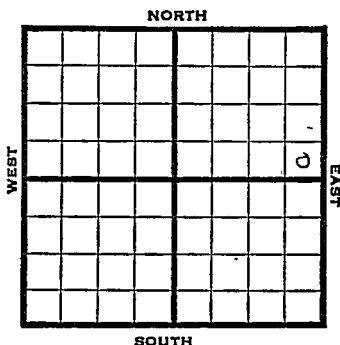

1948

Eli 1842'

R E P O R T

8/18

8" @ 526'

Anhy 787'

Drlg. 1330'

8/25

Drlg 2272'

9/1

"

9/8

Lansing 3019'

Arb. 3273'-75'

TD 3275'

5" @ 3273' 300' oil 1 hr

9/15

Arb. 3273'

5" @ 3273'

TD 3275'

3000 acid

Echo Pot 3000 oil

42° Gr.

Comp

**COMPLETED**

Barton County Kansas State

Map No. \_\_\_\_\_ Sec. 6 Twp. 16 R. 12W

Well No. 2 Staudinger "B"

Phil-Han Company

FIRST REPORT Contractor

SE NE

SECTION PLAT

\_\_\_\_\_ Ft. from N. Line

330

\_\_\_\_\_ Ft. from S. Line

330

\_\_\_\_\_ Ft. from E. Line

\_\_\_\_\_ Ft. from W. Line

							o

Kraft-Prusa Pool

Remarks:

8" @ 526

Anhy 787 drlg. 1330

Date

AUG 18 1948

Scout

S. J. LEWIS

Barton County Kansas State

Map No. 55 Sec. 6 Twp. 16 R. 12W

Well No. 2 Staudinger "B"

Phil-Han Company

**COMPLETE**

Contractor

SE NE

*E. 1842*  
**SECTION PLAT**

         Ft. from N. Line

330 Ft. from S. Line

330 Ft. from E. Line

         Ft. from W. Line


Kraft-Prusa Pool

Remarks:

*Ar 3223*

*5' @ 3223*

*AD 3225*

*3000 acid*

*Echo @ 3000 out*

*42.0/22*

Date  
SEP 15 1948

Scout **S. J. LEWIS**