


Section 2 Township 28 Range 8-E

Well No. #4 Edgar "A"

Company K.T. Widemann

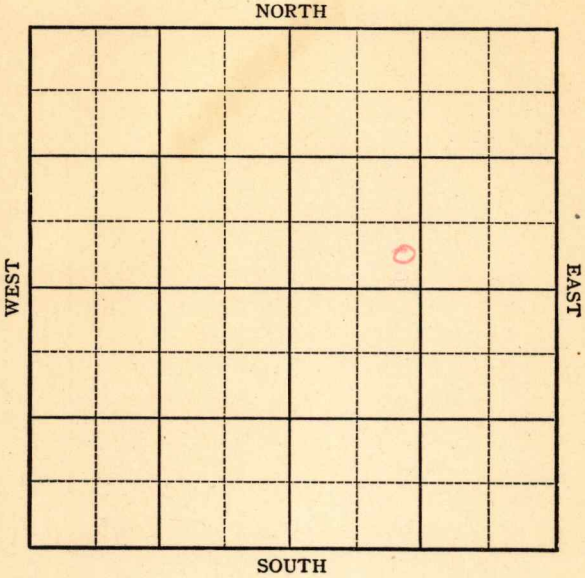

KANSAS

Greenwood County ✓

Sec. 2 Twp. 28 R. 8E

Well No. #4 Edgar "A" Farm

K. T. Weidemann Company

Miscellaneous

_____ Ft. from N. Line

330


_____ Ft. from S. Line

_____ Ft. from E. Line

990

_____ Ft. from W. Line

SE SW NE

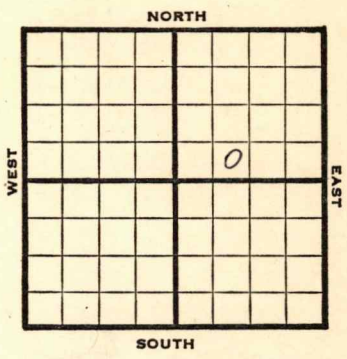

1946

REPORT

8/14	RUR
8/20	10" @ 25 ' Drlg 1800'
8/27	Miss 2481 TD 2505 4" @ 2483 RUST
9/5	" "
9/10	" "
9/18	" "
9/24	" "
10/1	" "
10/8	" "
10/15	" "
10/22	" "
10/29	" "
11/6	" "
11/12	" "
11/20	" "
11/27	Miss 2481' 4" @ 2483' TD 2506' 500 Acid Pump 15 POT 38 Grav.

COMPLETED

