

Barton

FORM 51 25M 8-50 WESTERN

KANSAS

Section 6 Township 16 Range 12W

Well No. #3 Staudinger "B"

Company Lee Phillips

NORTH

						0	

WEST

EAST

SOUTH

Barton

KANSAS

Sec. 6 Twp. 16 R. 12W ✓

Well No. #3 Staudinger "B" Farm

Lee Phillips Company

Anschutz - Contr. Contractor


Beaver Pool

Ft. from N. Line

330' Ft. from S. Line

990' Ft. from E. Line

Ft. from W. Line

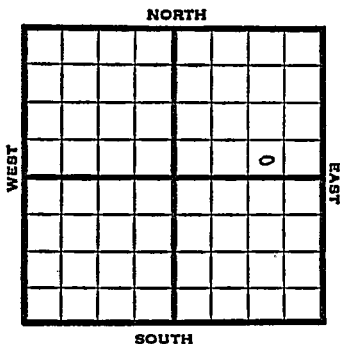

SW SE NE

1951 Elev. 1859' REPORT

5/9
6/20

Location
 Spud 5-21-51
 D&A TD 3307
 8-5/8" @ 446
 Anhy 800'
 Top 2692
 Heeb. 2943
 Br Lime 3030
 KC 3040
 Arb. ch 3298
 Arb. dol. 3300-02
 5 1/2" @ 3300 TD 3307
 S/l boph Hydrafrac
 No inc. D&A

ABANDONED

County Barton State Kansas

Sec. 6 (Blk.) 16 (Sur. Rge.) 12W Map No.

Operator Lee Phillips

Well No. 3 Farm Staudinger "B"

Elev. _____ Location SW SE NE

FIRST REPORT

330ft. From S Line NE

990ft. From E Line Quarter

Ist. Report MAY 9 1951

Completion _____

Remarks _____

Anschutz - Contr.

Spudding Date _____

Drig. Data Beaver Pool

Location

County Barton State Kansas

Sec. 6 (Blk.) 16 (Sur.) 12W Map No.

Operator Lee Phillips

Well No. 3 Farm Staudinger "B"

Elev. 1859 Location SW SE NE

330 Ft. From S Line NE

990 Ft. From E Line Quarter

1st. Report

Completion JUN 20 1951

Remarks Beaver Pool

Anschutz - Contr.

Spudding Date 5-21-51

Drilg. Data D & A TD 3307

8 5/8" @ 446 Anhy 800 Top. 2692

Heeb. 2943 Br. lime 3030 KC 3040

Arb. ch. 3298 Arb. dol. 3300-02

5 1/2" @ 3300 TD 3307 S/ 1 boph Hydrofrac

no inc. D & A