

Sec. 2 Twp. 28 Range 8 E

1 Edgar

Kansas Geological Society


Dr. Hibbard

Skelly Scout Tickets

Map No. Kansas Sec. 2 Twp. 28 R. 8
 Well No. 1 Edgar Farm
Dr. Hibbard Company

Greenwood

200 Ft. from N. Line
 _____ Ft. from S. Line
200 Ft. from E. Line
 _____ Ft. from W. Line

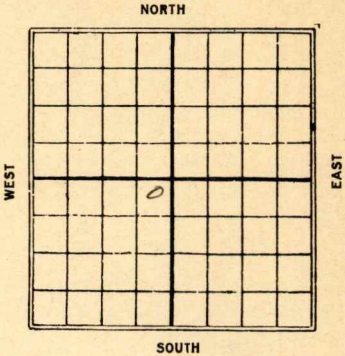

Date	REPORT
<u>1926</u>	
<u>7/9</u>	<u>Location</u>
<u>7/15</u>	<u>Rigging up.</u>
<u>7/22</u>	<u>—</u>
<u>7/28</u>	<u>—</u>
<u>8/4</u>	<u>—</u>
<u>8/11</u>	<u>—</u>
<u>8/18</u>	<u>same</u>
<u>8/25</u>	<u>—</u>
<u>8/31</u>	<u>Drly 1147</u>
<u>9/15</u>	<u>Drly 1495' - Crooked hole</u>
<u>9/22</u>	<u>Show oil 1825'-26</u>
	<u>Drly 1875'</u>
<u>9/29</u>	<u>same</u>
<u>10/3</u>	<u>same</u>
<u>10/27</u>	<u>S.D. 2550' with small show oil</u>
<u>11/6</u>	<u>Top Pay line 2558</u>
	<u>T.D. 2562 36 Gravity</u>
	<u>35 bbls no water (2ell)</u>
<u>11/10</u>	<u>Top sand 2558 T.D. 2567</u>
	<u>Pay 2558-2562 - Prod P.</u>
	<u>(2ell)</u>

11/17 - Correction - I.D. should
be 2567, shut down
will shoot

11/23 - Same

12/8 - Shot 20 gts, fsg
casing

12/15 - same

12/22 _____

12/30 _____

~~1927~~

1/6 _____

1/13 _____

1/19 _____

1/26 _____

2/3 _____

2/5 - after setting mouth, swabbed
80 bbls. then set 22 hrs.

swabbed 10 bbls. (tel)

2/10 - 10 bbl. show - drlg deeper

2/15 - T. D. 2701 - will plug (tel)

2/16 - miss lime 2558'

1st break 2563-67

20 gts / 10 bbl show

D. & A. 2701'

Sherwood

Map No. **K10** **KANSAS** Sec. **2** Twp. **28** R. **8**

Well No. **1** *Edgar*
Dr. Hibbard Company

Contractor

FIRST REPORTS

SECTION PLAT

200 Ft. from N. Line
Ft. from S. Line
200 Ft. from E. Line
Ft. from W. Line

	o		

Location _____
Rig up _____
Drilling and Remarks:

RECORD

Cased _____ in., _____ ft.
Sand _____
Gas _____
Oil _____
Total Depth _____

PRODUCTION

1st 24 hrs. Nat. _____
1st 24 hrs. after shot _____
Gas _____ Cu. Ft.
Dry Hole _____
Abandoned _____

Date

JUL 9 1926
192

CHAS. L. SHERWOOD

Scout

Sherwood

Map No. ¹⁰ **KANSAS** Sec. ⁷ Twp. ²⁸ R. ⁸

Well No. ¹ *60 yard*
Hibbard at AL

Company

Contractor

COMPLETED


SECTION PLAT

²⁰⁰ Ft. from N. Line

Ft. from S. Line

²⁰⁰ Ft. from E. Line

Ft. from W. Line

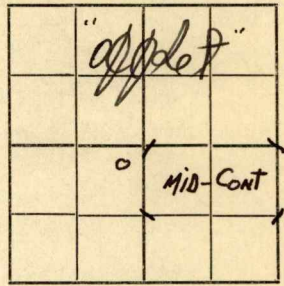

ABANDONED

Location

Rig up

Drilling and Remarks:

*Miss line 2558-
1st blow 2563-67
24 10 Bl show.*

DEH 2701

RECORD

Cased _____ in., _____ ft.

Sand _____

Gas _____

Oil _____

Total Depth 2701

PRODUCTION

1st 24 hrs. Nat. _____

1st 24 hrs. after shot _____

Gas _____ Cu. Ft.

Dry Hole

Abandoned

Date

FEB 16 1927

CHAS. L. SHERWOOD

192

Scout