
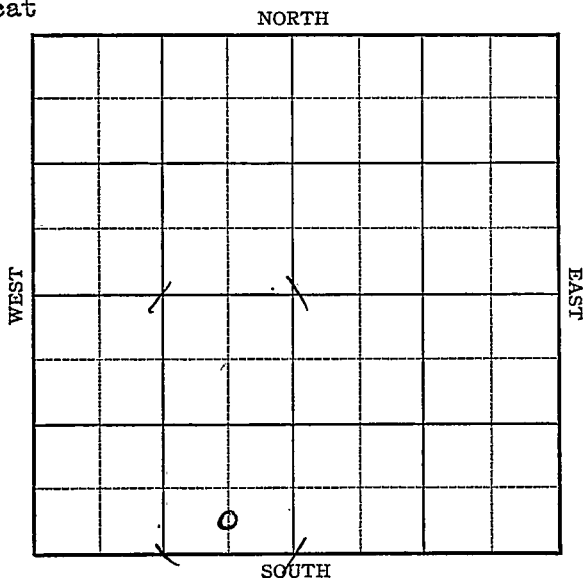


Barton

Section 6 Township 16 Range 12-WWell No. #1 StullCompany Appleman & Iron Drilling

Wildcat

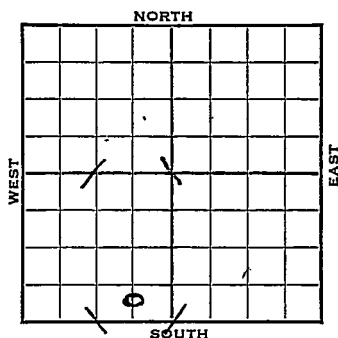

Sec. 6 Twp. 16 R. 12WWell No. #1 Stull FarmAppleman & Iron Drilling Company
(Wildcat) Ft. from N. Line330 Ft. from S. Line660 Ft. from E. Line Ft. from W. Line*Elw. 1869*

1942

REPORT

9/23 Surface hole

9/30 Drlg. 860 - 8" - 327. Anhy 815

10/7 Topeka 2710 Lans. 3041

Drlg. 3050 S 0

10/14 Lans 3021 (corrected) Sab.

Cong. 3296

Quartzite 3328

TD 3331

5" @ 3179 Rust.

10/21 " " " "

10/28 Rip csg 3118-30 $\frac{1}{2}$ 2500 acid~~Flow~~ estimate 100 oil per hr 4 hrs.

11/11 " " " "

11/18 " " " "

11/24 " " " "

12/2 Temp pob 408

12/9 " "

12/16 " "

12/22 " "

12/29- Lans 3021

Quartzite 3328 5" @ 3179'

T.D. 3332'

Rip csg. 3118-30 $\frac{1}{2}$ '

Pump 408 Pot. 5500 Acid

Gravity 40.1

COMPLETED

Map No. 55 Sec. 6 Twp. 16 R. 12W


Well No. 1 Stull

Appleman & Iron Drilling Company

FIRST REPORT Contractor

C S $\frac{1}{2}$ SE S $\frac{1}{2}$

SECTION PLAT

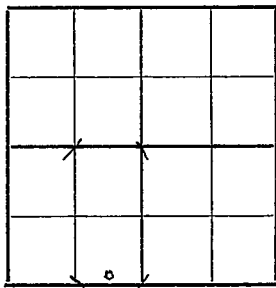

 Ft. from N. Line

330 Ft. from S. Line

660 Ft. from E. Line

 Ft. from W. Line

WILDCAT

RECORD

Location

Cased in., ft.

Rig up

Sand

Drilling and Remarks:

Gas

Oil

Total Depth

Surface Hole

PRODUCTION

1st 24 hrs. Nat.

1st 24 hrs. after Shot

Gas Cu. Ft.

Dry Hole

Abandoned

Date

SEP 23 1942 19 S. J. LEWIS Scout

KANSAS

Barton

Map No. 55 Sec. 6 Twp. 16 R. 12WWell No. 1 StullAppleman & Iron Drilling Company~~COMPLETED~~

Contractor

C S $\frac{1}{2}$ SE SW Ft. from N. Line330 Ft. from S. Line660 Ft. from E. Line Ft. from W. Line

SECTION PLAT

WILDCAT

Location Rig up

Drilling and Remarks:

Lane. 3021
Quartzite 3328
5" 3179
Rip Aug. 3118-30 1/2
5500 acid
Pump 408 P.D.
40-2-21

RECORD

Cased in., ft.Sand Gas Oil Total Depth 3332

PRODUCTION

1st 24 hrs. Nat. 1st 24 hrs. after shot Gas Cu. Ft.Dry Hole Abandoned

Date

DEC 29 1942

19

S. J. LEWIS Scout