

Well No. 15 Nupp Farm 1


Mr. Arthur M. Company

300 Ft. from N. Line

Ft. from S. Line

Ft. from E. Line

300 Ft. from W. Line

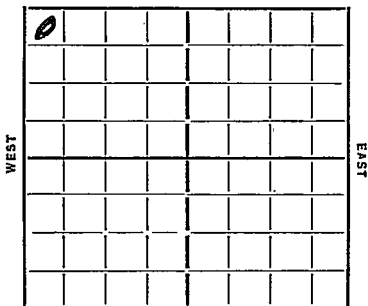

SOUTH •

Date 10/1/68 REPORT

1933	
8/21	Spunk
9/6	Weg 765
10/3	" 1365
10/9	TL 1529
	TJ 1569

D & A.

ABANDONED

Map No. 17 Sec. 20 Twp. 25 R. 13E

Well No. 1- Rupp

De Kintner et al Company

Contractor

FIRST REPORTS

SECTION PLAT

300 Ft. from N. Line

..... Ft. from S. Line

..... Ft. from E. Line

300 Ft. from W. Line

0			

Location.....

Rig up.....

Drilling and Remarks:

RECORD

Cased..... in., ft.

Sand.....

Gas.....

Oil.....

Total Depth.....

PRODUCTION

1st 24 hrs. Nat.....

1st 24 hrs. after shot.....

Gas..... Cu. Ft.

Dry Hole.....

Abandoned.....

Date

ORVAL MANNSCHRECK

8-21-35 192.....

Scout

Map No. 17 Sec. 20 Twp. 25 R. 14E

Well No. 1- Rupp.

DeGinter et al Company

Contractor

CORRECTION

300 Ft. from N. Line

_____ Ft. from S. Line

_____ Ft. from E. Line

300 Ft. from W. Line

CORRECTION

SECTION PLAT

0			

Location _____

Rig up _____

Drilling and Remarks:

*formerly
reported as
Range 13E*

RECORD

Cased _____ in., _____ ft.

Sand _____

Gas _____

Oil _____

Total Depth _____

PRODUCTION

1st 24 hrs. Nat. _____

1st 24 hrs. after shot _____

Gas _____ Cu. Ft.

Dry Hole _____

Abandoned _____

Date

8-28-35 192

ORVAL MANNSCHN Scout

KANSAS

Map No. 17 Sec. 20 Twp. 25 R. 14 EWell No. 1-Rupp
De Linther et al Company~~ABANDONED~~

Contractor

SECTION PLAT

300 Ft. from N. Line

..... Ft. from S. Line

..... Ft. from E. Line

300 Ft. from W. Line

0			

Location.....

Rig up.....

Drilling and Remarks:

RECORD

Cased..... in., ft.

Sand TL 1529

Gas.....

Oil.....

Total Depth 1569

PRODUCTION

1st 24 hrs. Nat.

1st 24 hrs. after shot.....

Gas..... Cu. Ft.

Dry Hole.....

Abandoned.....

Date

ORVAL MANNSCHECK

10-9-35 192..... Scout