


SECTION 22 TOWNSHIP 25 RANGE 14E

WELL NO. #1 G.A. Rife

COMPANY Thunderbird Petr.

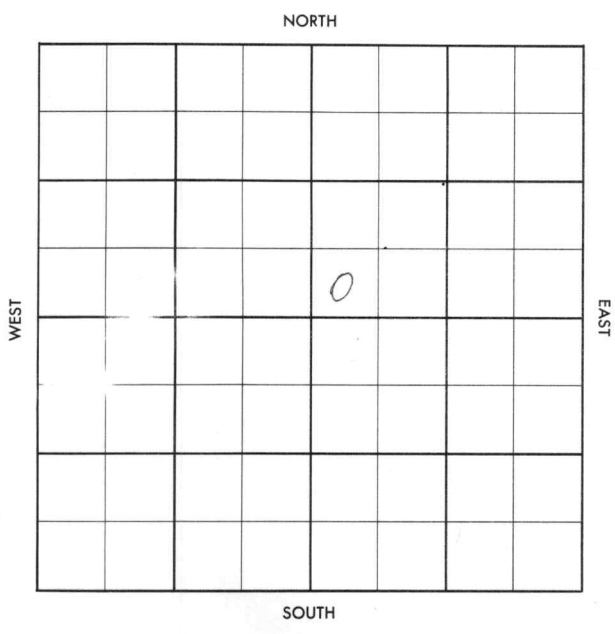

Woodson

KANSAS

SEC. 22	TWP. 25	R. 14E
---------	---------	--------

WELL NO. #1 G. A. Rife FARM

COMPANY Thunderbird Pet.

CONTRACTOR

**Batesville**


\_\_\_\_\_ FT. FROM N. LINE

\_\_\_\_\_ FT. FROM S. LINE

\_\_\_\_\_ FT. FROM E. LINE

\_\_\_\_\_ FT. FROM W. LINE

SW SW NE

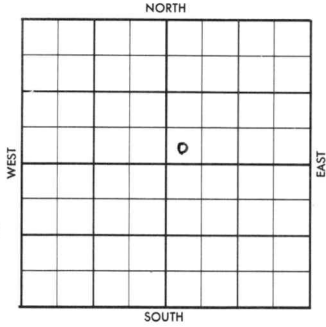

1956	ELEVATION	REPORT
------	-----------	--------

9-12	Comm 9-9-56	
------	-------------	--

County Woodson Elev. \_\_\_\_\_  
 Sec. 22 Twp. 25 Rge. 11E  
 Company Thunderbird Pet.  
 Farm Name G. A. Rife No. 1

TOPS	DEPTH	LOG	DATUM	Loc. in Sec.
Anh.				SW SW NE
TP.				
H.				
Tr.				
Dg.				
Bl.				
L.				Geol. _____
K.C.				Contr. _____
B.K.C.				
Ce.				
C.				
M.				
M.				Pool
K.				<u>Batesville</u>
Mz.				<div style="border: 1px dashed black; padding: 5px; text-align: center;">                     SEP 12 '56                      0                      FIRST REPORT                 </div>
Mq.				
V.				
S.				
S.				
A.				
R.				
Pf.				
G.				
T.D.				

Date Comm. 9-9-56

37

SEP 10 1956  
 J.M. M.

Co. Lse. No. Sec. T. R.

County Woodson Elev. \_\_\_\_\_  
 Sec. 22 Twp. 25 Rge. 11E  
 Company Thunderbird Pet.  
 Farm Name G. A. Rife No. 1

TOPS	DEPTH	LOG	DATUM	Loc. in Sec.
Anh.				SW SW NE
Tp.				
H.				
Tr.				
Dg.				
Bl.				
L. <u>Bartl.</u>	<u>1440</u>			Geol.
K.C.				Contr.
B.K.C.				
Ce.				
C.				
M. <u>1488</u>	<del>1438</del>			Pool
M.				Batesville
K.				
Mz.				
Me.				
V.				
S.				
S.				
A.				
R.				
PE.				
G.				
TD.	<u>1547</u>			

OCT	3	'56
	0	
ABANDONED		

Date Comm. 9-9-56 SEP 19 '56  
85/8 @ 811 @ 1100 SEP 26 '56

OCT 3 '56

D.E.A.

Co. No. Use. No. Sec. T. R.