


Map No. Kansas Sec. 9 Twp. 28 R. 11

Well No. 1 Knoll Farm

Owen Osage Company

NORTH

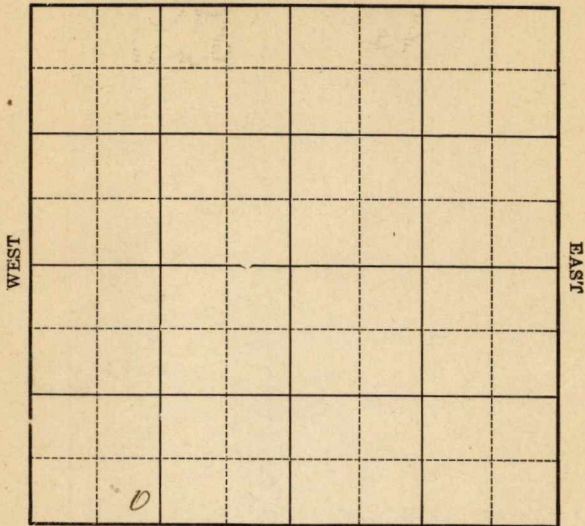

SOUTH

Location _____

Drilling Remarks _____

Rig Up _____

Drilling Remarks _____

RECORD

Cased _____ in. _____ ft.

Sand _____

Gas _____

Oil _____

Total Depth _____

PRODUCTION

1st 24 hrs. Nat. _____

1st 24 hrs. after shot _____

Gas _____ cu. ft.

Dry Hole _____


Abandoned _____

Map No. Kansas Greenwood Sec. 9 Twp. 28 R. 11

Well No. 1 Knoll Farm

Owen Osage Company

NORTH

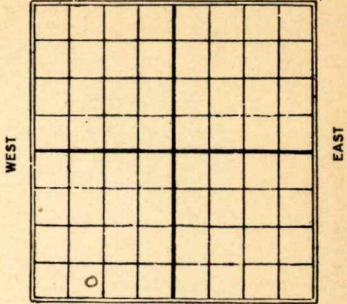

_____ Ft. from N. Line

200 Ft. from S. Line

_____ Ft. from E. Line

1120 Ft. from W. Line

Date

REPORT

1926

5/26 Slg 1175'

6/2 Same

6/10 _____

6/18 _____

6/24 S. & A. 1926'

Steenwood

Map No. *K9* **KANSAS** Sec. *9* Twp. *28* R. *11*

Well No. *1* *Kroll*

Owens Odage Company

Contractor

FIRST REPORTS

SECTION PLAT

_____ Ft. from N. Line

200

_____ Ft. from S. Line

_____ Ft. from E. Line

1120

_____ Ft. from W. Line

<i>o</i>			

Location _____

Rig up _____

Drilling and Remarks:

Only 1175'

RECORD

Cased _____ in., _____ ft.

Sand _____

Gas _____

Oil _____

Total Depth _____

PRODUCTION

1st 24 hrs. Nat. _____

1st 24 hrs. after shot _____

Gas _____ Cu. Ft.

Dry Hole _____

Abandoned _____

Date

MAY 26 1926

192

CHAS. L. SHERWOOD

Scout

Floreswood

K9 KANSAS Map No. _____ Sec. *9* Twp. *28* R. *11*

Well No. *1* *Roll*

owner stage

Company _____

Contractor _____

COMPLETED

SECTION PLAT

_____ Ft. from N. Line

200

_____ Ft. from S. Line

_____ Ft. from E. Line

1/20

_____ Ft. from W. Line

ABANDONED

<i>0</i>			

Location _____

Rig up _____

Drilling and Remarks:

DLG

1926'

RECORD

Cased _____ in., _____ ft.

Sand _____

Gas _____

Oil _____

Total Depth *1926*

PRODUCTION

1st 24 hrs. Nat. _____

1st 24 hrs. after shot _____

Gas _____ Cu. Ft.

Dry Hole

Abandoned

Date

JUN 24 1926

192

CHAS. L. SHERWOOD

Scout