


Map No. _____ Sec. 10 Twp. 28 R. 11

Well No. 1 Starkey Farm _____
McColm Co. Company _____

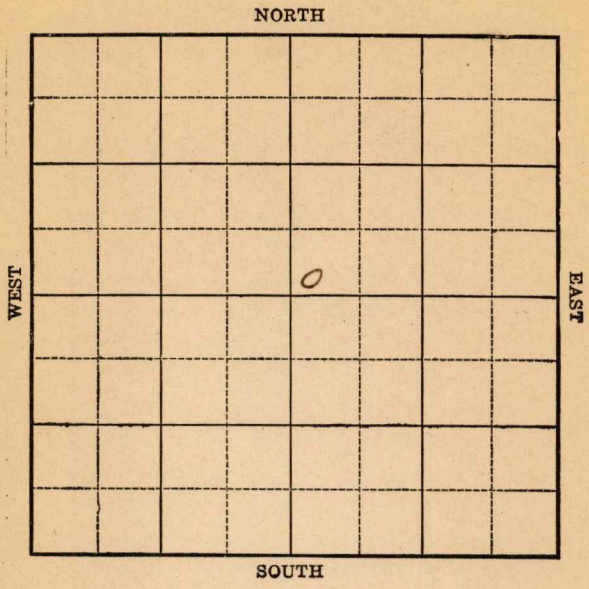

Location _____

Drilling Remarks:

Rig up _____

Drilling Remarks:

RECORD

Cased _____ in. _____ ft.

Sand _____

Gas _____

Oil _____

Total Depth _____

PRODUCTION

1st 24 hrs Nat. _____

1st 24 hrs. after shot _____

Gas _____ cu. ft.

Dry Hole _____

Abandoned _____

Map No. ~~AN 508~~ 9 Sec. 10 Twp. 28 R. 11

Well No. 1 Starkey
Mc Colm Company

Contractor

ABANDONED SECTION PLAT

----- Ft. from N. Line

200 Ft. from S. Line

----- Ft. from E. Line

200 Ft. from W. Line

		o	

Location -----

Rig up -----

Drilling and Remarks:

1049
1974

RECORD

Cased ----- in., ----- ft.

Sand -----

Gas -----

Oil -----

Total Depth -----

PRODUCTION

1st 24 hrs. Nat. -----

1st 24 hrs. after shot -----

Gas ----- Cu. Ft.

Dry Hole -----

Abandoned -----

Date

MAY 19 1923

M. A. BENEAR

Map No. **KANSAS** 9 Sec. 10 Twp. 28 R. 11

Well No. 1 Starkey

McCalm et al Company

Contractor

FIRST REPORT

SECTION PLAT

Ft. from N. Line

200 Ft. from S. Line

Ft. from E. Line

200 Ft. from W. Line

		0	

Location

Rig up

Drilling and Remarks:

Machine

RECORD

Cased in., ft.

Sand

Gas

Oil

Total Depth

PRODUCTION

1st 24 hrs. Nat.

1st 24 hrs. after shot

Gas Cu. Ft.

Dry Hole

Abandoned

Date

MAR 2 1923

M. A. BENEAR

191

Scout