


Section 22 Township 25 Range 14-E

Well No. #2 Shepperd

Company Anderson etal

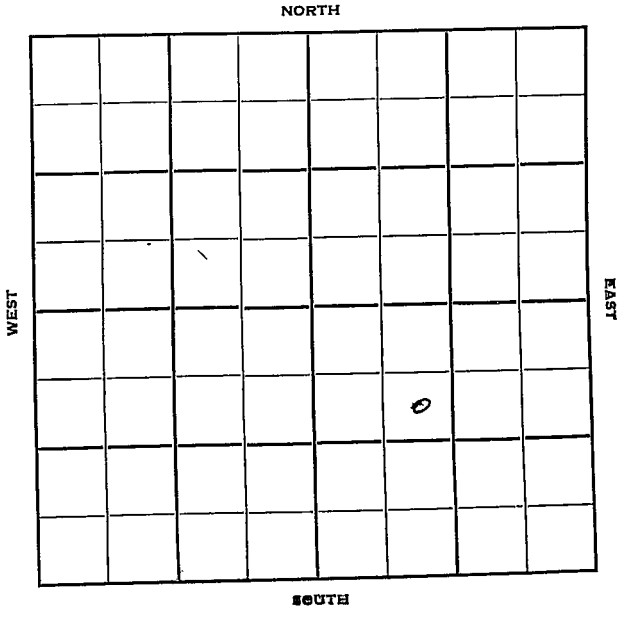

Woodson

KANSAS

Sec. 22 Twp. 25 R. 14E

Well No. #2 Shepperd Farm

Anderson et al Company

Contractor

Miscellaneous


990' Ft. from N. Line

\_\_\_\_\_ Ft. from S. Line

\_\_\_\_\_ Ft. from E. Line

990' Ft. from W. Line

SE NW SE

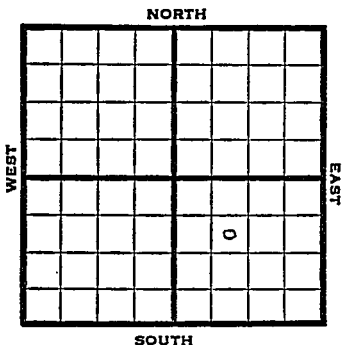

1950

REPORT

2/22 Drlg. 75'

3/15 TD 1562'  
8"@ 915'  
D&A  
Aband.

**ABANDONED**

Map No. \_\_\_\_\_ Sec. 22 Twp. 25 R. 14E

Well No. 2 Shepperd

\_\_\_\_\_ Anderson etal. \_\_\_\_\_ Company

\_\_\_\_\_ Contractor

SE NW SE


**SECTION PLAT**

990 Ft. from N. Line

\_\_\_\_\_ Ft. from S. Line

\_\_\_\_\_ Ft. from E. Line

990 Ft. from W. Line

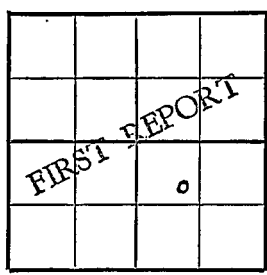

Woodson County

Location \_\_\_\_\_

Rig up \_\_\_\_\_

Drilling and Remarks:

drlg. 75

**RECORD**

Cased \_\_\_\_\_ in., \_\_\_\_\_ ft.

Sand \_\_\_\_\_

Gas \_\_\_\_\_

Oil \_\_\_\_\_

Total Depth \_\_\_\_\_

**PRODUCTION**

1st 24 hrs. Nat. \_\_\_\_\_

1st 24 hrs. after shot \_\_\_\_\_

Gas \_\_\_\_\_ Cu. Ft.

Dry Hole \_\_\_\_\_

Abandoned \_\_\_\_\_

Date

FEB 22 1950 19 J. E. TYRA Scout

Kansas

Map No. \_\_\_\_\_ Sec. 22 Twp. 25 R. 14E

Well No. 2 Shepperd

Anderson etal. \_\_\_\_\_ Company

\_\_\_\_\_  
Contractor

SE NW SE


990 Ft. from N. Line

\_\_\_\_\_ Ft. from S. Line

\_\_\_\_\_ Ft. from E. Line

990 Ft. from W. Line

## SECTION PLAT

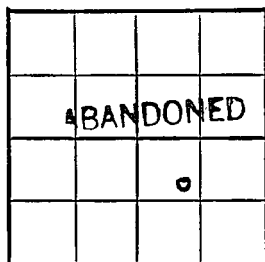

Woodson County

Location \_\_\_\_\_

Rig up \_\_\_\_\_

Drilling and Remarks:

8' @ 915

T.D. 1562

D+A

## RECORD

Cased \_\_\_\_\_ in., \_\_\_\_\_ ft.

Sand \_\_\_\_\_

Gas \_\_\_\_\_

Oil \_\_\_\_\_

Total Depth \_\_\_\_\_

## PRODUCTION

1st 24-hrs. Nat. \_\_\_\_\_

1st 24 hrs. after shot \_\_\_\_\_

Gas \_\_\_\_\_ Cu. Ft.

Dry Hole \_\_\_\_\_

Abandoned \_\_\_\_\_

Date

MAR 15 1950 19

J. E. TYRA Scout