

KANSAS

Butler


FORM 51 5M BRIX

KANSAS

Section 16 Township 28 Range 8E

Well No. #2, Fouts

Company K. T. Weidemann

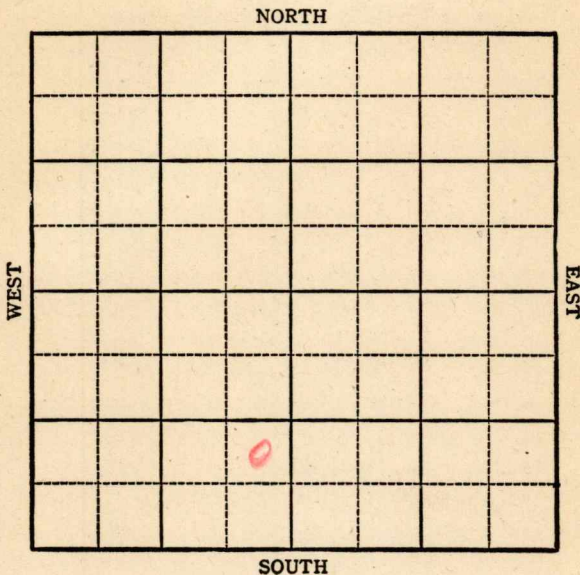

KANSAS

Butler County

Sec. 16 Twp. 28 R. 8E

Well No. 2, Fouts Farm

K. T. Weidemann Company


Miscellaneous

 Ft. from N. Line

990 Ft. from S. Line

330 Ft. from E. Line

 Ft. from W. Line

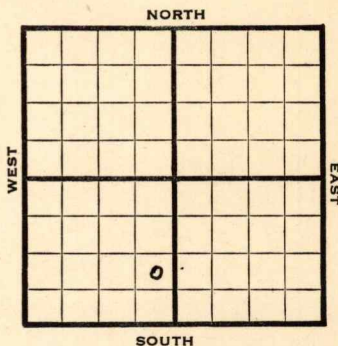

1944

REPORT

7/5	Cellar
7/12	Spd SD
7/19	" "
7/26	10" @ 16½'
	KC 1952
	Drlg. 1998'
8/2	Miss. 2714
	TD 2718
	5" @ 2718 RUST
8/9	" " " "
8/16	" " " "
8/23	" " " "
8/30	" " " "
9/6	Miss 2714
	5" @ 2718
	TD 2723
	Pump 45 pot.
	36 Gravity

COMPLETED

Pool Name Miscellaneous**KANSAS**Map No. 10 Sec. 16 Twp. 28 R. 8EWell No. 2 FoutsK. T. Weidemann CompanyFIRST REPORT

Contractor

NE SE SW

SECTION PLAT

 Ft. from N. Line990 Ft. from S. Line330 Ft. from E. Line Ft. from W. LineButler CountyLocation Rig up

Drilling and Remarks:

Cellar

RECORD

Cased in., ft.Sand Gas Oil Total Depth

PRODUCTION

1st 24 hrs. Nat. 1st 24 hrs. after shot Gas Cu. Ft.Dry Hole Abandoned

Date

JUL 5 1944 19 S. J. LEWIS Scout

KANSAS Pool Name MiscellaneousMap No. 10 Sec. 16 Twp. 28 R. 8EWell No. 2 FoutsK. T. Weidemann Company**COMPLETED**

Contractor

NE SE SW

SECTION PLAT

	6		

 Ft. from N. Line990 Ft. from S. Line330 Ft. from E. Line Ft. from W. LineButler CountyLocation Rig up

Drilling and Remarks:

*Misc 2714**5' to 2718.**Prng 4500 ft.**1962*

RECORD

Cased in., ft.Sand Gas Oil Total Depth 2729

PRODUCTION

1st 24 hrs. Nat. 1st 24 hrs. after shot Gas Cu. Ft.Dry Hole Abandoned

Date

SEP 6 1944 19

S. J. LEWIS Scout