


Map No. K9 Sec. 9 Twp. 28 R. 11
Well No. 1 Hart
Ossenbeck et al Company
Contractor

NORTH

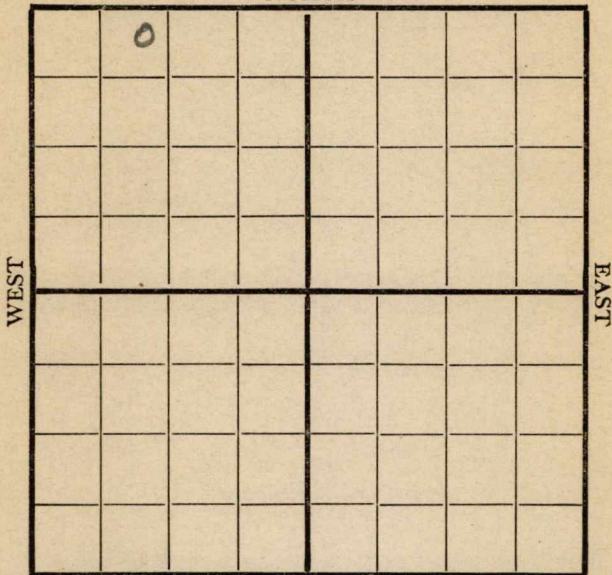

300-N SOUTH 1100-W

Location _____

Rig up _____

Drilling and Remarks:

P. D. @
600'

RECORD

Cased _____ in., _____ ft.

Sand _____

Gas _____

Oil _____

Total Depth _____

PRODUCTION

1st 24 hrs. Nat. _____

1st 24 hrs. after shot _____

Gas _____ Cu. Ft.

Dry Hole _____

Abandoned _____

Date

12/24 1918

Pyle

Scout

Map No. K9 Sec. 9 Twp. 28 R. 11

Well No. 1 Hart

Ossenbeck et al Company

Contractor

NORTH

WEST

EAST

	0					

300-N

SOUTH

1100-W

Location _____

Rig up _____

Drilling and Remarks:

600'
D. W. for
crew

RECORD

Cased _____ in., _____ ft.

Sand _____

Gas _____

Oil _____

Total Depth _____

PRODUCTION

1st 24 hrs. Nat. _____

1st 24 hrs. after shot _____

Gas _____ Cu. Ft.

Dry Hole _____

Abandoned _____

Date

12/17 1918

Pyle


Scout

Map No. K9 Sec. 9 Twp. 28 R. 11

Well No. 1 Hart
Ossenbeck et al Company

Contractor

NORTH

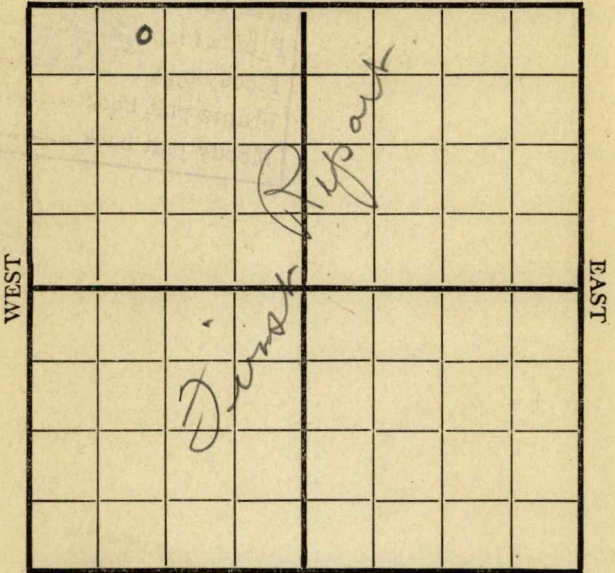

300-N

SOUTH

1100-W

Location _____

Rig up _____

Drilling and Remarks:

600'
in 12 1/2" hole

RECORD

Cased _____ in., _____ ft.

Sand _____

Gas _____

Oil _____

Total Depth _____

PRODUCTION

1st 24 hrs. Nat. _____

1st 24 hrs. after shot _____

Gas _____ Cu. Ft.

Dry Hole _____

Abandoned _____

Date

12/14 1918

H. B.


Scout

Map No. K 9 Sec. 9 Twp. 28 R. 11

Well No. 1 Hart
Ossenbeck et al Company

Contractor

NORTH

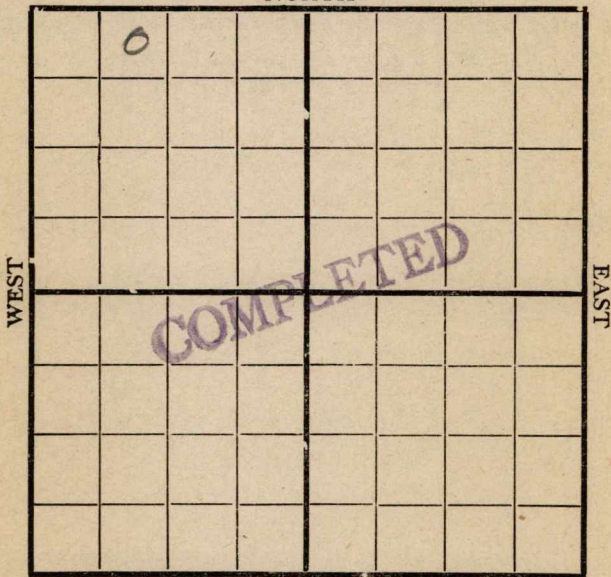

300 N

SOUTH

1100 W

Location _____

Rig up _____

Drilling and Remarks:

RECORD

Cased _____ in., _____ ft.

Sand _____

Gas _____

Oil _____

Total Depth _____

PRODUCTION

1st 24 hrs. Nat. _____

1st 24 hrs. after shot _____

Gas _____ Cu. Ft.

Dry Hole 2060 _____

Abandoned _____

Date

Feb 1 1919

Pyle

Scout

Map No. K9 Sec. 9 Twp. 28 R. 11

Well No. 1 Start
Ossenbeck et al Company

Contractor

NORTH

		0					

WEST

EAST

300N

SOUTH

1100W

Location

Rig up

Drilling and Remarks:

Light show
1530-1545
Set 6" @ 1612
D. D.

RECORD

Cased..... in., ft.

Sand.....

Gas.....

Oil.....

Total Depth.....

PRODUCTION

1st 24 hrs. Nat.

1st 24 hrs. after shot.....

Gas..... Cu. Ft.

Dry Hole.....

Abandoned.....

Date

Jan 24 191*9*

Pyle

Scout