


Map No. _____ Sec. 10 Twp. 28 R. 11

Well No. 1 Shultz Farm _____
McGowan & Co Company _____

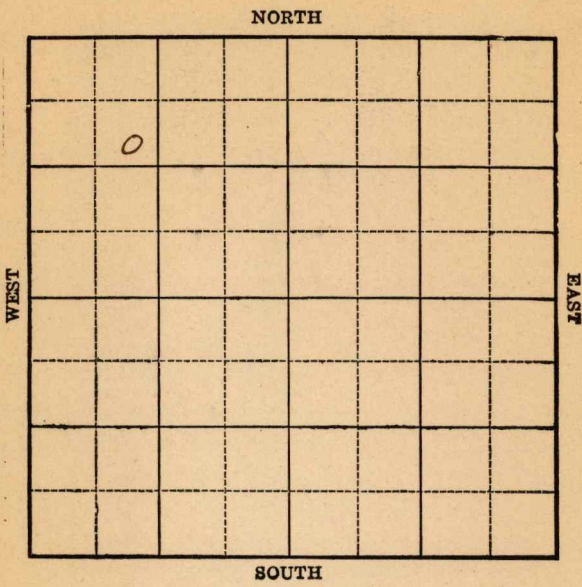

Location _____

Drilling Remarks:

Rig up _____

Drilling Remarks:

RECORD

PRODUCTION

Cased _____ in. _____ ft.

Sand _____

Gas _____

Oil _____

Total Depth _____

1st 24 hrs Nat. _____

1st 24 hrs. after shot _____

Gas _____ cu. ft.

Dry Hole _____

Abandoned _____

Map No. _____ Sec. 10 Twp. 28 R. 11

Well No. 1 Shultz Farm _____
McColm & Co Company _____


NORTH

1120 Ft. from N. Line

_____ Ft. from S. Line

_____ Ft. from E. Line

1120 Ft. from W. Line

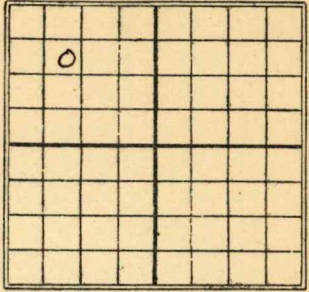

SOUTH

Date
1923

REPORT

1/4 Sand 1034-41-3 4A Gas
JD. 1041'

Kansas

Map No. *K9* Sec. *10* Twp. *28* R. *11*

Well No. *1 Shultz*
Mc Colm Stat Company

Contractor

*First Report
& Completed*

SECTION PLAT

<i>o</i>			

1120 Ft. from N. Line

----- Ft. from S. Line

----- Ft. from E. Line

1120 Ft. from W. Line

RECORD

Location -----

Rig up -----

Drilling and Remarks:

*Gas well
sand.
1034-41
3 M Gas*

Cased ----- in., ----- ft.

Sand -----

Gas -----

Oil -----

Total Depth *1041*

PRODUCTION

1st 24 hrs. Nat. -----

1st 24 hrs. after shot -----

Gas ----- Cu. Ft.

Dry Hole -----

Abandoned -----

Date

1/4 191 *23* *M.B.* Scout