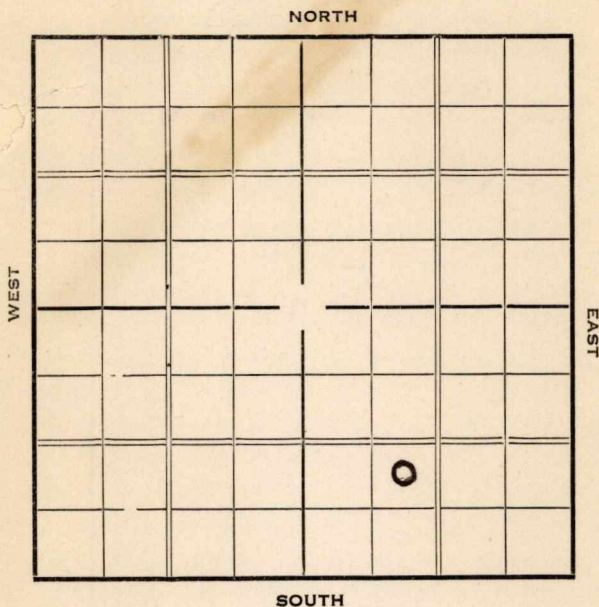


Section 12 Township 28 Range 1-EWell Number 1 - BemisCompany Van Deventer

Greenwood

Map No. 9 Sec. 12 Twp. 28 R. 11 ^E

Well No. 1 - Bemis

Van Deventer Company

Contractor

FIRST REPORT

SECTION PLAT

_____ Ft. from N. Line

990 Ft. from S. Line

_____ Ft. from E. Line

990 Ft. from W. Line

		0	

Location _____

Rig up _____

Drilling and Remarks:

10" - 200

8" - 405

6" - 1030

Dlg 1100

RECORD

Cased _____ in., _____ ft.

Sand _____

Gas _____

Oil _____

Total Depth _____

PRODUCTION

1st 24 hrs. Nat. _____

1st 24 hrs. after shot _____

Gas _____ Cu. Ft.

Dry Hole _____

Abandoned _____

Date

MAY 5 - 1937

19

H. D. Hatfield Scout

KANSAS

Greenwood

Map No. 9 Sec. 12 Twp. 28 R. 11 EWell No. 1-BernisVan Deventer et al Company

Contractor

COMPLETED

SECTION PLAT

		0	

Ft. from N. Line

990 Ft. from S. Line

Ft. from E. Line

990 Ft. from W. Line

Location _____

Rig up _____

Drilling and Remarks:

D & A

RECORD

Cased _____ in., _____ ft.

Sand _____

Gas _____

Oil _____

Total Depth 1315 ft.

PRODUCTION

1st 24 hrs. Nat. _____

1st 24 hrs. after shot _____

Gas _____ Cu. Ft.

Dry Hole _____

Abandoned _____

Date

MAY 19 1937

19

H. D. Hatfield

Scout