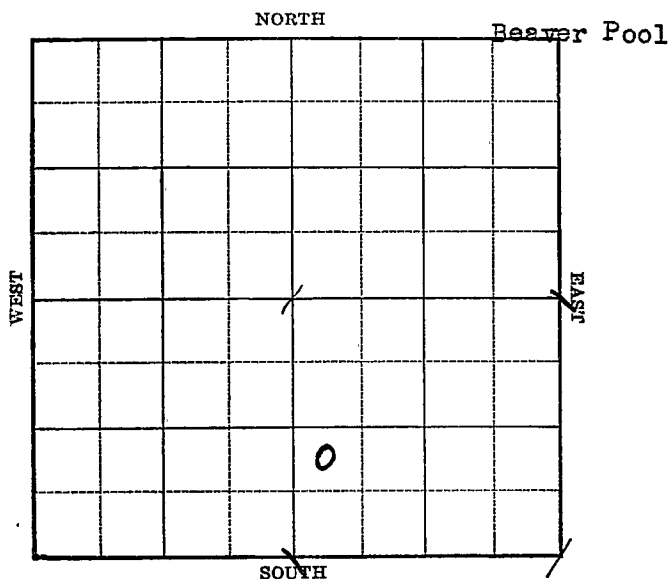


KANSAS

Barton

Section 8 Township 16 Range 12-WWell No. #1 FeltesCompany Paul Martin et al

1939

4/7 4000 acid. Flowed 336 oil in
3 hrs. On potential.
Est. 7 M gas.

4/12 8" - 2858'
Topeka 2680'
T. D. 2906'
4000 acid.
Flow 849 bbls. 8 hrs.
Potential 2546 bbls. .
10 M cu. ft. gas.

COMPLETED


Barton

Map No. 55 Sec. 8 Twp. 16 R. 12WWell No. 1 FeltesPaul Martin etal Company

Contractor

FIRST REPORT
NW SW SE*Sinclair F.O.*
SECTION PLAT Ft. from N. Line990 Ft. from S. Line Ft. from E. Line330 Ft. from W. Line

BEAVER POOL

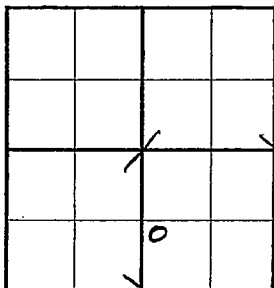Location Rig up

Drilling and Remarks:

Matl.

RECORD

Cased in., ft.Sand Gas Oil Total Depth

PRODUCTION

1st 24 hrs. Nat. 1st 24 hrs. after shot Gas Cu. Ft.Dry Hole Abandoned

Date

JAN 18 1929 19 H. D. Hatfield Scout

Barton

KANSAS

Map No. 55 Sec. 8 Twp. 16 R. 12WWell No. 1 FeltesPaul Martin et al

Company

Contractor

COMPLETED

NW SW SE

 Ft. from N. Line990 Ft. from S. Line Ft. from E. Line330 Ft. from W. Line

BEAVER POOL

SECTION PLAT

		0	

Location Rig up

Drilling and Remarks:

4000 Acid
Flow 84 9/8
POT 2546
gas - 10 M.

RECORD

Cased 8 in., 2858 ft.~~Sand~~ Topeka 2680Gas Oil Total Depth 2906

PRODUCTION

1st 24 hrs. Nat. 1st 24 hrs. after shot Gas Cu. Ft.Dry Hole Abandoned

Date

APR 12 1939

19

H. D. Hatfield Scout