


KANSAS Barton county

Section 8 Township 16 Range 12W

Well No. #1, Bushnell

Company Black-Marshall

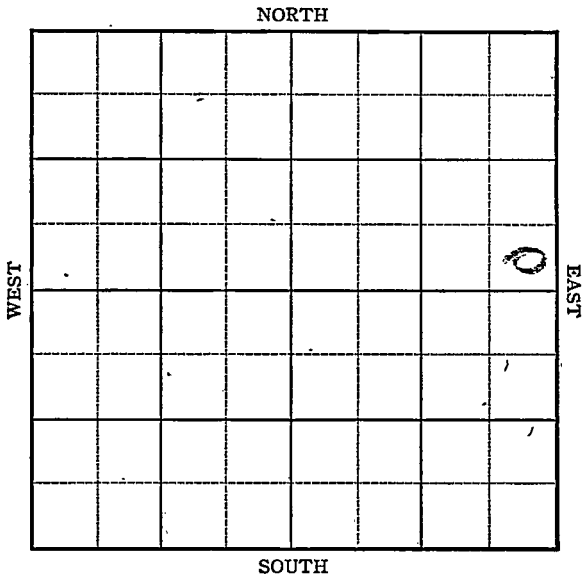

Sec. 8 Twp. 16 R. 12W

Well No. #1 Bushnell Farm

Black-Marshall Company

Kraft-Prusa


_____ Ft. from N. Line

330 Ft. from S. Line

330 Ft. from E. Line

_____ Ft. from W. Line

SE NE

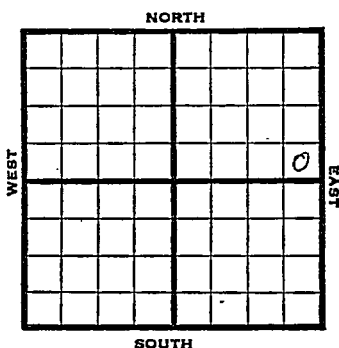

1946 Elev. 1893 REPORT

4/24	Location
5/1	"
5/7	"
5/14	Rig
5/21	12" @ 420' Drlg 520'
5/29	Anhy. 795 Drlg. 1610'
6/5	8" @ 2097 Drlg. 2410'
6/12	Drlg 2775'
6/18	Topeka 2685' Lans 3065 7" @ 3105' Drlg 3145'
6/26	7" @ 3214 Cong 3325' TD 3343 5" @ 3338 WOC
7/3	TD 3344 1200' oil 1 hrs
7/10	Cong. 3325 5" @ 3338 TD 3344' Pump 493 oil plus 15% W. Pot. Grav. 42.0

COMPLETED

KANSAS

Kansas Pool Name Kraft-Prusa

Map No. 43 Sec. 8 Twp. 16 R. 12W

Well No. 1 Bushnell

Black-Marshall

Company

FIRST REPORT

Contractor

SE NE

SECTION PLAT

 Ft. from N. Line

330 Ft. from S. Line

330 Ft. from E. Line

 Ft. from W. Line

			o

Barton County

Location X

Rig up

Drilling and Remarks:

RECORD

Cased in., ft.

Sand

Gas

Oil

Total Depth

PRODUCTION

1st 24 hrs. Nat.

1st 24 hrs. after shot

Gas Cu. Ft.

Dry Hole

Abandoned

Date

APR 24 1946

19

S. J. LEWIS

Scout

KANSAS

Kansas Pool Name Kraft-Prusa Pool

Map No. 65 Sec. 8 Twp. 16 R. 12W

Well No. 1 Bushnell

Black-Marshall Company

COMPLETED

Contractor

SE NE

E 1/8 23
SECTION PLAT

			0

_____ Ft. from N. Line

330 Ft. from S. Line

330 Ft. from E. Line

_____ Ft. from W. Line

Barton County

Location _____

Rig up _____

Drilling and Remarks:

Cong 3325
5' C 3338
Pump 493 bit
15' W Pat

42' G/L

RECORD

Cased _____ in; _____ ft.

Sand _____

Gas _____

Oil _____

Total Depth 3344

PRODUCTION

1st 24 hrs. Nat. _____

1st 24 hrs. after shot _____

Gas _____ Cu. Ft.

Dry Hole _____

Abandoned _____

Date

JUL 10 1946 19

S. J. LEWIS Scout