




Section 16 Township 28 Range 11-E

Well No. #1 Pottorff

Company Coulter & Janney

NORTH Severy Pool

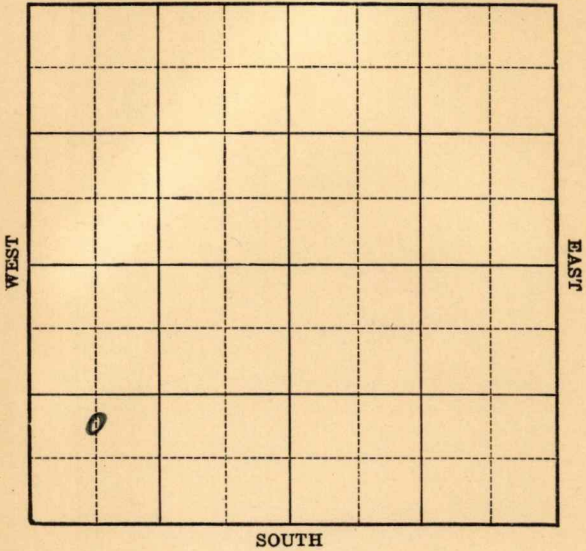

Map No. 9 Sec. 16 Twp. 28 R. 11E

Well No. 1 Pottorff

Coulter & Janney Company

Contractor

ABANDONED

SECTION PLAT

C N L SW SW

0			

_____ Ft. from N. Line

990 Ft. from S. Line

_____ Ft. from E. Line

660 Ft. from W. Line

SEVERY POOL

Location _____

RECORD

Rig up _____

Cased _____ in., _____ ft.

Drilling and Remarks:

Sand _____

Gas _____

Oil _____

Total Depth 1221

KC 1177

5" @ 1177

HFW.

PRODUCTION

1st 24 hrs. Nat. _____

1st 24 hrs. after shot _____

Gas _____ Cu. Ft.

Dry Hole _____

Abandoned _____

Date

JUL 24 1940 19

S. J. LEWIS Scout

