


Section 16 Township 28 Range 11-E

Well No. 1 Pottorff

Company Blue Stem Oil

Severy Pool

NORTH

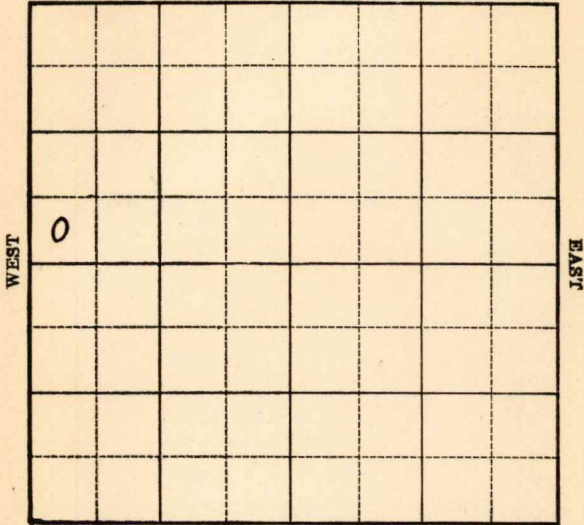

SOUTH

WEST

EAST

Sec. 16 Twp. 28 R. 11-E

Well No. #1 Pottorff Farm

Blue Stem Oil Company


(Severy)

\_\_\_\_\_ Ft. from N. Line

330 Ft. from S. Line

\_\_\_\_\_ Ft. from E. Line

330 Ft. from W. Line

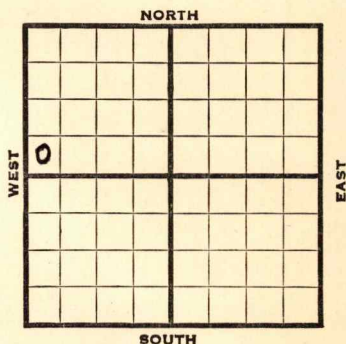

1939	REPORT
2/15	Drlg. 370'
2/23	" "
3/3	8" - 400' SD 490'
3/10	" " " "
3/17	" " " "
3/24	T. D. 875'. SD for csg.
3/31	No dope.
4/7	SD csg. T.D. 875'
4/14	" " " "
4/21	" " " "
4/28	" " " "
5/5	" " " "
5/12	" " " "
5/19	" " " "
5/26	" " " "
6/1	" " " "
6/8	" " " "
6/16	" " " "
6/23	" " " "
6/29	" " " "
7/6	" " " "
7/13	" " " "

1939

7/20 TD 875'  
SD for csg.

7/27 " "

8/2 T.D. 1230'

ABANDONED

Map No. 9 Sec. 16 Twp. 28 R. 11E

Well No. 1 Pottorff

Blue Stem Oil Company

Contractor

**FIRST REPORT**

SW NW

\_\_\_\_\_ Ft. from N. Line

330 Ft. from S. Line

\_\_\_\_\_ Ft. from E. Line

330 Ft. from W. Line

**SECTION PLAT**

0			

**SEVERY POOL**

Location \_\_\_\_\_

Rig up \_\_\_\_\_

Drilling and Remarks:

Dr lg. 370

**RECORD**

Cased \_\_\_\_\_ in., \_\_\_\_\_ ft.

Sand \_\_\_\_\_

Gas \_\_\_\_\_

Oil \_\_\_\_\_

Total Depth \_\_\_\_\_

**PRODUCTION**

1st 24 hrs. Nat. \_\_\_\_\_

1st 24 hrs. after shot \_\_\_\_\_

Gas \_\_\_\_\_ Cu. Ft.

Dry Hole \_\_\_\_\_

Abandoned \_\_\_\_\_

Date

FEB 15 1939

19

H. D. Hatfield Scout

Map No. 9 Sec. 16 Twp. 28 R. 11 E

Well No. 1 Pottorff

Blue Stem Company

Contractor

ABANDONED

SECTION PLAT

SW NW

0			

\_\_\_\_\_ Ft. from N. Line

330 Ft. from S. Line

\_\_\_\_\_ Ft. from E. Line

330 Ft. from W. Line

SEVERY POOL

RECORD

Location \_\_\_\_\_

Cased \_\_\_\_\_ in., \_\_\_\_\_ ft.

Rig up \_\_\_\_\_

Sand \_\_\_\_\_

Drilling and Remarks:

Gas \_\_\_\_\_

Oil \_\_\_\_\_

Total Depth 1230

PRODUCTION

1st 24 hrs. Nat. \_\_\_\_\_

1st 24 hrs. after shot \_\_\_\_\_

Gas \_\_\_\_\_ Cu. Ft.

Dry Hole \_\_\_\_\_

Abandoned \_\_\_\_\_

Date

AUG 2 1939

19

S. J. LEWIS

Scout