


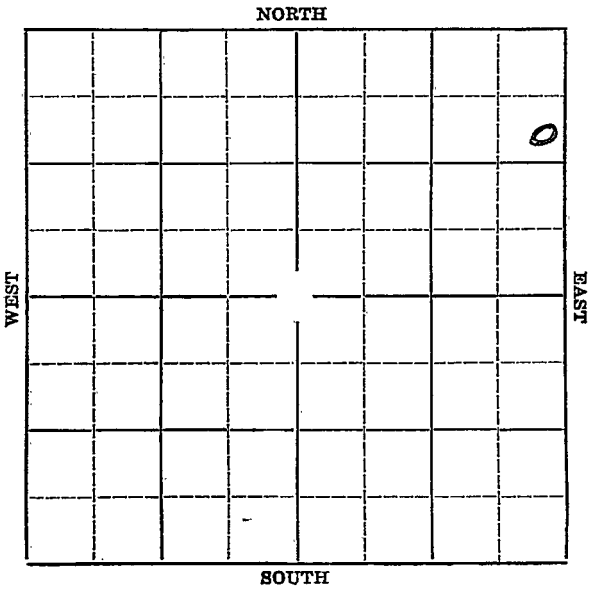

Section 25 Township 25 Range 14-E

Well Number #1-fee

Company Holmes et al



Sec. 25 Twp. 25 R. 14E

Well No. #1 Fee Farm


Holmes et al Company

1100' Ft. from N. Line

_____ Ft. from S. Line

250' Ft. from E. Line

_____ Ft. from W. Line

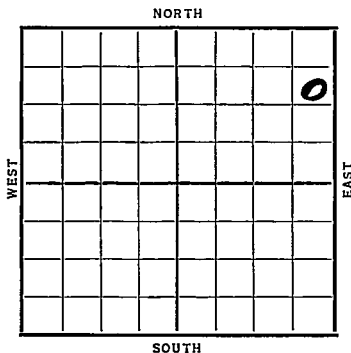

Date	REPORT
1936	
9/9	Machine Rigging up.
9/18	Rigging up.
9/24	Drlg. 615'.
10/1	No report.
10/7/36	-Mississippi Lime. 1450'.
	T.D. 1492'.
	Dry and abandoned.
	ABANDONED

KANSAS

Form 26—1M Bks.—2-29

Map No. 17 Sec. 25 Twp. 25 R. 14E

Well No. 1 Fee

Holmes & Co. Company

Contractor

SECTION PLAT

			o

1100 Ft. from N. Line

_____ Ft. from S. Line

250 Ft. from E. Line

_____ Ft. from W. Line

FIRST REPORT

Location: _____

Rig up _____

Drilling and Remarks:

*Mach
Rigging up.*

RECORD

Cased _____ in., _____ ft.

Sand _____

Gas _____

Oil _____

Total Depth _____

PRODUCTION

1st 24 hrs. Nat. _____

1st 24 hrs. after shot _____

Gas _____ Cu. Ft.

Dry Hole _____

Abandoned _____

Date

SEP 9 1936-19

S. J. LEWIS Scout

Map No. 17 Sec. 25 Twp. 25 R. 14E

Well No. 1 Fee

Holmes & Dal Company

Contractor

SECTION PLAT

			0

1100 Ft. from N. Line

_____ Ft. from S. Line

250 Ft. from E. Line

_____ Ft. from W. Line

ABANDONED

Location _____

Rig up _____

Drilling and Remarks:

Miss L1450

JVA

RECORD

Cased _____ in., _____ ft.

Sand _____

Gas _____

Oil _____

Total Depth 1492

PRODUCTION

1st 24 hrs. Nat. _____

1st 24 hrs. after shot _____

Gas _____ Cu. Ft.

Dry Hole _____

Abandoned _____

Date

OCT 7 1936 19

S. J. LEWIS Scout