

Section 8 Township 16 Range 12W

Well No. 7 Feltes

Company Franco Central

Kraft-Prusa Pool

NORTH

							0

WEST

EAST

SOUTH



Sec. 8 Twp. 16 R. 12-W

Well No. #7 Feltes Farm

Francor Central Company

Kraff-Prusa Pool


990 Ft. from N. Line

_____ Ft. from S. Line

330 Ft. from E. Line

_____ Ft. from W. Line

SE NE SE

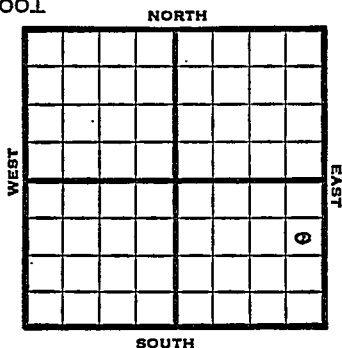

1948

Eli 1894'

REPORT

- 10/6 Rig
- 10/13 "
- 10/19 Drlg 340'
- 10/26 13" @ 395'
Drlg 700'
- 11/3 10" @ 800'
Drlg. 1950'
- 11/10 Drlg. 2210'
- 11/16 8" @ 2220'
Drlg. 2430'
- 11/23 "
- 11/30 Lansing 3053'-3090'
2700' oil 12 hrs.
- 12/8 7" @ 3088'
Drlg 3180'
- 12/15 5" @ 3294'
Drlg 3300'
- 12/22 TD 3324'
- 12/29 Lans. 3053'
Quartzite 3302'
5" @ 3294'
Perf Lans 5000 acid
Pump 50 oil Pot
42° Gr.
Comp

COMPLETED

Map No. _____ Sec. 8 Twp. 16 R. 12W

Well No. 7 Feltes

Franco Central Company

FIRST REPORT Contractor _____

SE NE SE

SECTION PLAT

990 Ft. from N. Line

_____ Ft. from S. Line

330 Ft. from E. Line

_____ Ft. from W. Line

			o

Barton County

Location _____

Rig up _____

Drilling and Remarks:

Rig _____

RECORD

Cased _____ in., _____ ft.

Sand _____

Gas _____

Oil _____

Total Depth _____

PRODUCTION

1st 24 hrs. Nat. _____

1st 24 hrs. after shot _____

Gas _____ Cu. Ft.

Dry Hole _____

Abandoned _____

Date

OCT 6 1948 19 _____ S. J. LEWIS Scout

Map No. 55 Sec. 8 Twp. 16 R. 12WWell No. 7 Feltes

Franco Central

Company

COMPLETE

Contractor

SE NE SE

E. 11894
SECTION PLAT990 Ft. from N. Line

Ft. from S. Line

330 Ft. from E. Line

Ft. from W. Line

			0

Barton County

Location

Rig up

Drilling and Remarks:


Date

RECORD

Cased _____ in., _____ ft.

Sand _____

Gas _____

Oil Total Depth 3324

PRODUCTION

1st 24 hrs. Nat. _____

1st 24 hrs. after shot. _____

Gas _____ Cu. Ft.

Dry Hole _____

Abandoned _____

DEC 29 1948 19

S. J. LEWIS Scout