KANSAS


FORM 51 5M 1-42 PETROL

Barton

Section 8 Township 16 Range 12-W

Well No. #1 Standinger

Company Darby

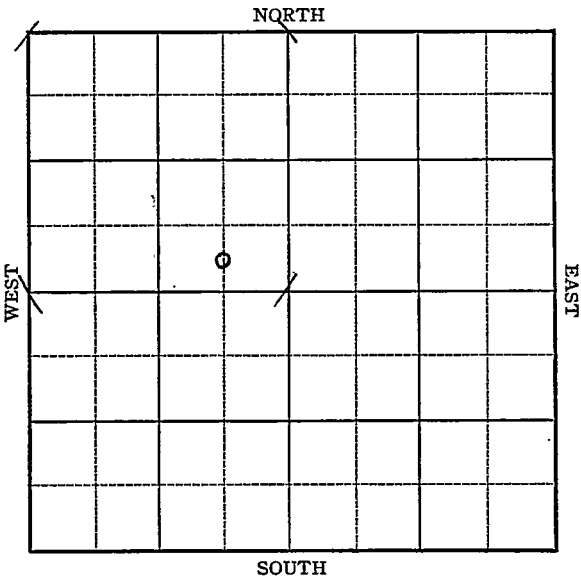

FORM 252-A
5M 9-42 GASS


KANSAS

Barton

Sec. 8 Twp. 16 R. 12-W

Well No. #1 Standinger Farm

Darby Company

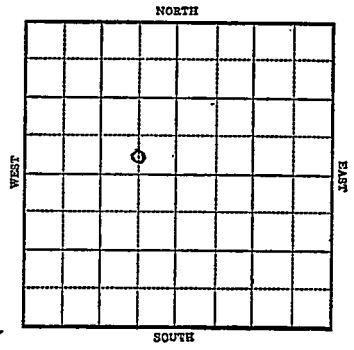

_____ Ft. from N. Line

330 Ft. from S. Line

660 Ft. from E. Line

_____ Ft. from W. Line

Elev. 1884

1943	REPORT
5/5	Rotary
5/12	Surface hole
5/19	Anhy 811 10" @ 820' WOC.
5/26	Quartzite 3344 No shows T.D. 3349'

ABANDONED

Form 26 200 Bks. 5-42 Petrol

KANSAS Barton

Map No. 55 Sec. 8 Twp. 16 R. 12W


Well No. 1 Standinger

Darby Company

FIRST REPORT Contractor

C SL SE NW

SECTION PLAT

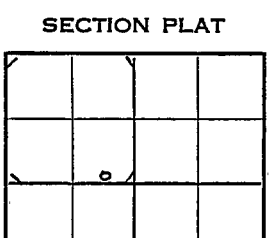

Ft. from N. Line

330 Ft. from S. Line

660 Ft. from E. Line

Ft. from W. Line

BEAVER POOL

Location

Rig up

Drilling and Remarks:

Rotary

RECORD

Cased in., ft.

Sand

Gas

Oil

Total Depth

PRODUCTION

1st 24 hrs. Nat.

1st 24 hrs. after shot

Gas Cu. Ft.

Dry Hole

Abandoned

Date

MAY 5 1943 19

S. J. LEWIS Scout

Form 26 200 Bks 5-42 Petrol

KANSAS

Barton

Map No. 53 Sec. 8 Twp. 16 R. 12W


Well No. 1 Standinger

Darby Company

ABANDONED Contractor

C SL SE NW

SECTION PLAT

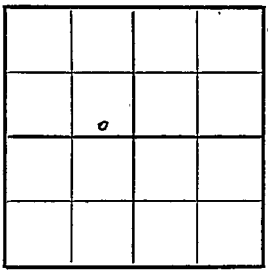

Ft. from N. Line

330 Ft. from S. Line

660 Ft. from E. Line

Ft. from W. Line

BEAVER POOL

Location

Rig up

Drilling and Remarks:

Quartzite 3344

Noelwood

RECORD

Cased in., ft.

Sand

Gas

Oil

Total Depth 3349

PRODUCTION

1st 24 hrs. Nat.

1st 24 hrs. after shot

Gas Cu. Ft.

Dry Hole

Abandoned

Date

MAY 2 6 1943 19

S. J. LEWIS Scout