


FORM 51

Section 28 Township 25 Range 13E

Well No. Dillion, Jeffries & Bumpus

Company 1 Dillion

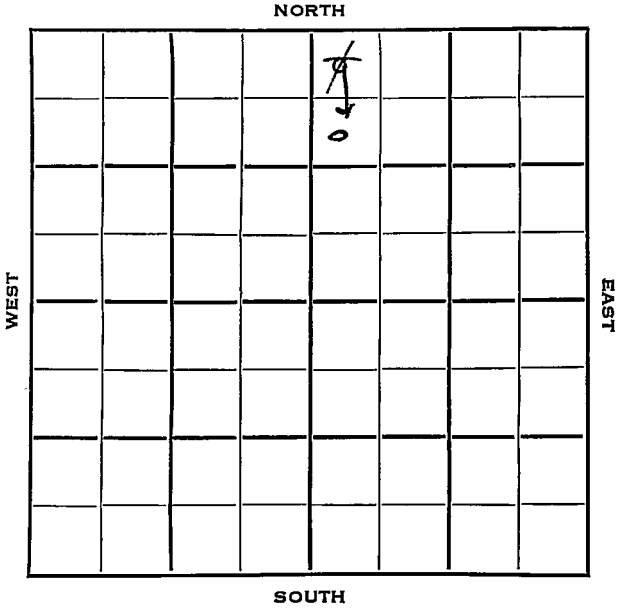

Greenwood

Sec. 28 Twp. 25 R. 13E

Well No. #Dillion Farm

Dillion, Jeffries & Bumpus Company

Wildcat Contractor


~~330~~ 990 Ft. from N. Line

_____ Ft. from S. Line

_____ Ft. from E. Line

330 Ft. from W. Line

~~NW NW NE~~
SW NW NE

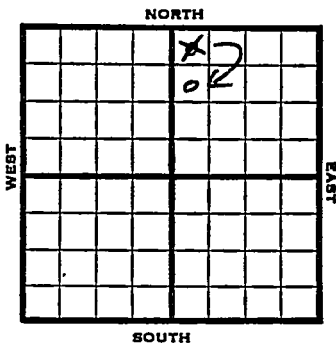

1953 Elev. = REPORT

4/1 Miss 1520
6" @ 1438

4/22 D & A
TD 1550'
6" @ 1438'
Miss 1520'
OTD 1550'
D & A

ABANDONED

County Greenwood State Kansas

Sec. 28 (Blk. Twp.) 25 (Sur. Rge.) 13E Map No.

Operator Dillion, Jeffries & Bumpus

Well No. 1 Farm Dillion

Elev. _____ Location NW NW NE

			0		
FIRST REPORT					

330 Ft. From N Line 

330 Ft. From W Line Quarter

1st. Report APR 1 1953

Completion _____

Remarks _____

Spudding Date _____

Drig. Data Wildcat

Miss. 1520 6" @ 1438

Kansas

Map No. _____ Sec. 28 Twp. 25 R. 13E

Well No. 1 Dillion

Dillion, Jeffries & Bumpus Company

CORRECTION

Contractor

SW NW NE

SECTION PLAT

990 Ft. from N. Line

_____ Ft. from S. Line

_____ Ft. from E. Line

330 Ft. from W. Line

		o	

Greenwood County

Location _____

Rig up _____

Drilling and Remarks:

Reported

NW NW NE

RECORD

Cased _____ in., _____ ft.

Sand _____

Gas _____

Oil _____

Total Depth _____

PRODUCTION

1st 24 hrs. Nat. _____

1st 24 hrs. after shot _____

Gas _____ Cu. Ft.

Dry Hole _____

Abandoned _____

Date

APR 22 1953

J. G. McGFHFF Scout

