


Section 8 Township 28 Range 12E

Well No. #1 Brunch

Company Shamrock Drlg.

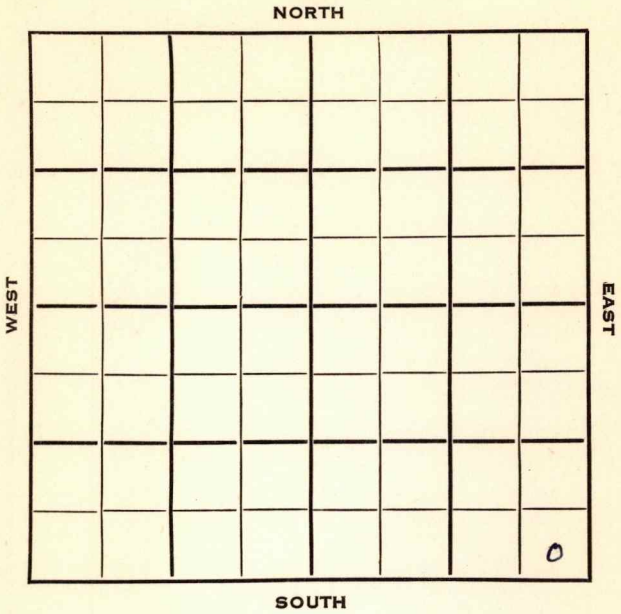

Greenwood

KANSAS



Sec. 8 Twp. 28 R. 12 E

Well No. # 1 Brunch Farm

Shamrock Drlg. Company

Shamrock Drlg. Contractor


Ft. from N. Line

350 Ft. from S. Line

350 Ft. from E. Line

Ft. from W. Line

SE SE SE (Twin well)

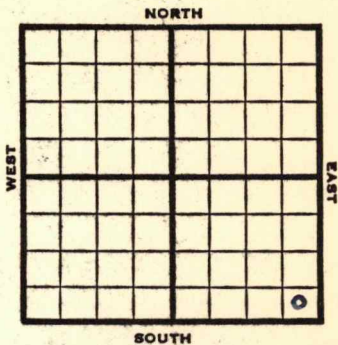

1953

REPORT

2/18

D & A - TD 1762'  
Miss 1698' TD 1762' HFW  
D & A

**FIRST REPORT**  
~~✓~~  
**ABANDONED**

County Greenwood State Kansas

Sec. 8 (Blk. 28 (Sur. Rge.) 12E Map No.

Operator Shamrock Drlg.

Well No. 1 Farm Brunch

Elev. Location SE SE SE (twin well)



350 Ft. From S Line SE

350 Ft. From E Line Quarter

1st. Report FEB 18 1953

Completion FEB 18 1953

Remarks Shamrock Drlg. - Contr.

Spudding Date

Drlg. Data D & A TD 1762

Miss. 1698 TD 1762 HFV D & A