


Map No. *No Map* Sec. *29* Twp. *25* R. *13*

Well No. *1 Gartner* Farm

Irwin Strauss et al Company.

NORTH

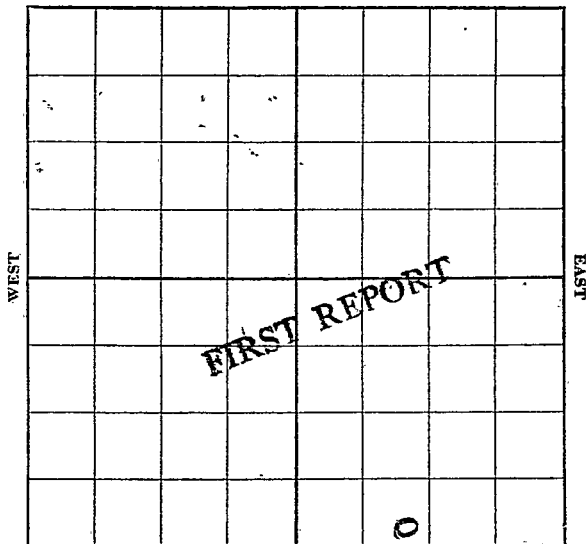

100 S

SOUTH

1120 W

RECORD

Location *↙*

Rig up

Drilling and Remarks:

Cased in., ft.

Sand

Gas

Oil

Total Depth

PRODUCTION

1st 24 hrs. Nat.

1st 24 hrs. after shot

Gas Cu. Ft.

Dry Hole

Abandoned

Date

7/21 *0*

Pyke

Scout.

Map No. No Map Sec. 29 Twp. 25 R. 13

Well No. 1 Partner
Strauss et al Company

Contractor

SECTION PLAT

COMPLETED

----- Ft. from N. Line
200 Ft. from S. Line
 ----- Ft. from E. Line
1120 Ft. from W. Line

Location -----
 Rig up -----
 Drilling and Remarks: .

RECORD

Cased ----- in., ----- ft.
 Sand -----
 Gas -----
 Oil -----
 Total Depth -----

PRODUCTION

1st 24 hrs. Nat. -----
 1st 24 hrs. after shot -----
 Gas ----- Cu. Ft.
 Dry Hole 1575
 Abandoned -----

Date
10/20 1920

Pyle Scout