

Map No. _____ Sec. 8 Twp. 20 R. 12

Well No. 1 Crawford Farm

Simms Oil Company

NORTH

WEST

EAST

SOUTH

Location _____

Drilling Remarks

Rig Up _____

Drilling Remarks

RECORD

Cased_____in. _____ft.

Sand

Gas

Oil

Total Depth.....

PRODUCTION

1st 24 hrs. Nat. _____

1st. 24 hrs. after shot_____


Gas _____ cu. ft.

Dry Hole.....

Abandoned

Map No. Kans Sec. 8 Twp. 28 R. 12
 Well No. 1 Crawford Farm
Simms Pet. Company

NORTH

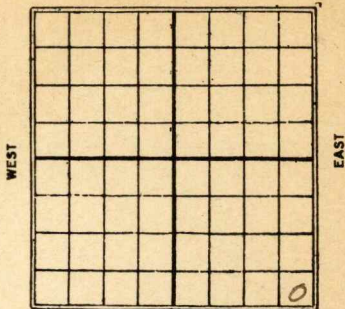

Ft. from N. Line

200 Ft. from S. Line200 Ft. from E. Line

Ft. from W. Line

1925

Date

REPORT

8/14 Mach Rigin up8/20 200'8/27 750'9/3 16509/11 1st Gas 1100-1107-2 barrels
Oil 1107-1112 2 bbls.9/16 Top Line 1630 2 bbls. 17359/24 5.10. 1750 for fuel9/21 8.17 1830 for order 4 P.W.10/810/16 Abandoned 1837

W. Benwood & Co
 K9 KANSAS Sec. *8* Twp. *28* R. *12*
 Map No. _____
 Well No. *1 Crawford* _____
Sumner oil Co _____ Company

Contractor _____

COMPLETED

SECTION PLAT

_____ Ft. from N. Line

200 _____ Ft. from S. Line*200* _____ Ft. from E. Line

_____ Ft. from W. Line

ABANDONED

Location _____

Rig up _____

Drilling and Remarks:

1 1/2 gals 1100-1107
2 barrels oil 1107-
11 1/2. Top Line 1630
Dry & hnd
2.2. 1827'

RECORD

Cased _____ in., _____ ft.

Sand _____

Gas _____

Oil _____

Total Depth *1827' HW*

PRODUCTION

1st 24 hrs. Nat. _____

1st 24 hrs. after shot _____

Gas _____ Cu. Ft.

Dry Hole ☒ _____

Abandoned _____

Date

OCT 16 1925

192

CHAS. L. SHERWOOD

Scout

Sherwood Co

Map No. **KANSAS** Sec. *8* Twp. *28* R. *12*

Well No. *1* *Olawford*

Simms *oil* *Co* Company

Contractor

FIRST REPORTS

SECTION PLAT

_____ Ft. from N. Line

200 _____ Ft. from S. Line

200 _____ Ft. from E. Line

_____ Ft. from W. Line

Location _____

Rig up *"Machine"*

Drilling and Remarks:

Bigging up

RECORD

Cased _____ in., _____ ft.

Sand _____

Gas _____

Oil _____

Total Depth _____

PRODUCTION

1st 24 hrs. Nat. _____

1st 24 hrs. after shot _____

Gas _____ Cu. Ft.

Dry Hole _____

Abandoned _____

Date

AUG 14 1925

_____ 192_____

CHAS. L. SHERWOOD

Scout