


Map No. _____ Sec. 9 Twp. 28 R. 12

Well No. 1 Morgan Farm

Victor F. Seymoure Company

NORTH

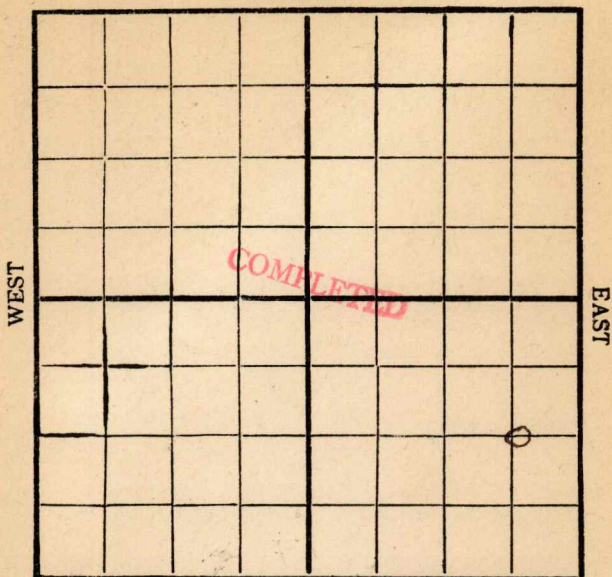

SOUTH

Location -----

Drilling Remarks:

Rig Up -----

Drilling Remarks:

RECORD

Cased-----in. -----ft.

Sand -----

Gas -----

Oil_____

Total Depth -----

PRODUCTION

1st 24 hrs. Nat.-----

1st 24 hrs. after shot-----

Gas_____cu. ft.


Dry Hole _____

Abandoned -----

Map No. K 9 Sec. 9 Twp. 28 R. 12Well No. 1 Morgan
Victor & Seymour Company

Contractor

NORTH

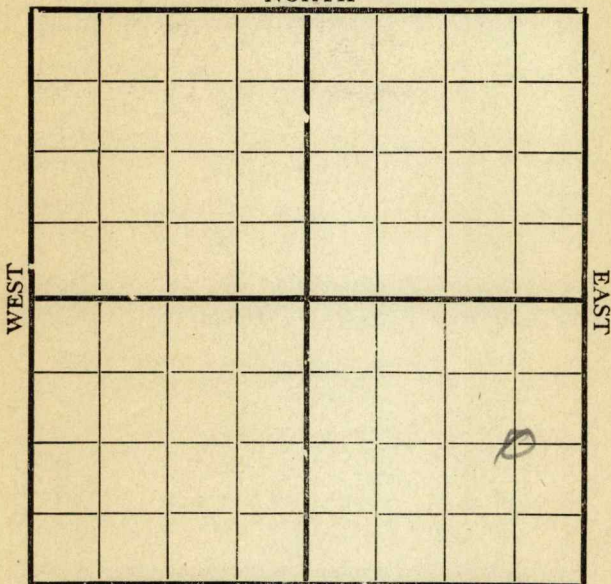660 E

SOUTH

1320 S

Location _____

Rig up _____

Drilling and Remarks:

960'

RECORD

Cased _____ in., _____ ft.

Sand _____

Gas _____

Oil _____

Total Depth _____

PRODUCTION

1st 24 hrs. Nat. _____

1st 24 hrs. after shot _____

Gas _____ Cu. Ft.

Dry Hole _____


Abandoned _____

Date

6/181919Cyle

Scout

Map No. K 9 Sec. 9 Twp. 28 R. 12
Well No. 1 Morgan
Victor & Seymour Company
Contractor

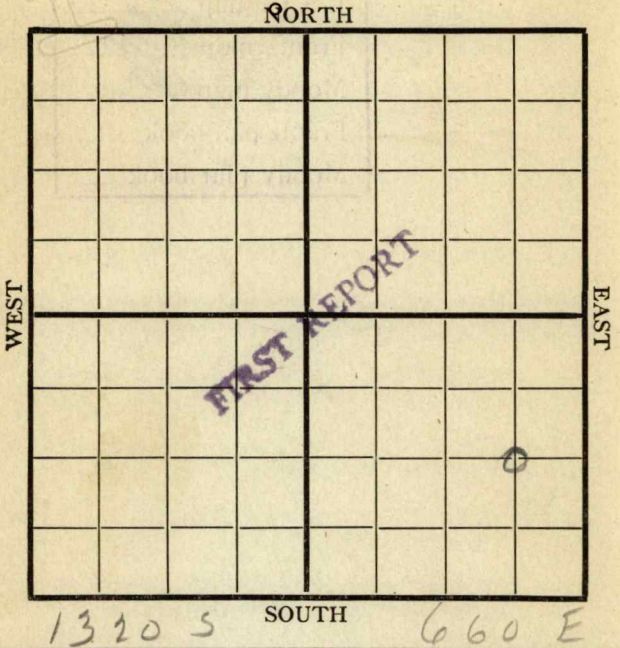

Location _____
Rig up _____
Drilling and Remarks:
*Shedding
850*

RECORD

Cased _____ in., _____ ft.
Sand _____
Gas _____
Oil _____
Total Depth _____

PRODUCTION

1st 24 hrs. Nat. _____
1st 24 hrs. after shot _____
Gas _____ Cu. Ft.
Dry Hole _____
Abandoned _____

Date 6/12 1919 Cyle Scout


Map No. K 9 Sec. 9 Twp. 28 R. 12Well No. 1 Morgan
Victor & Seymour Company

Contractor

NORTH

WEST

EAST

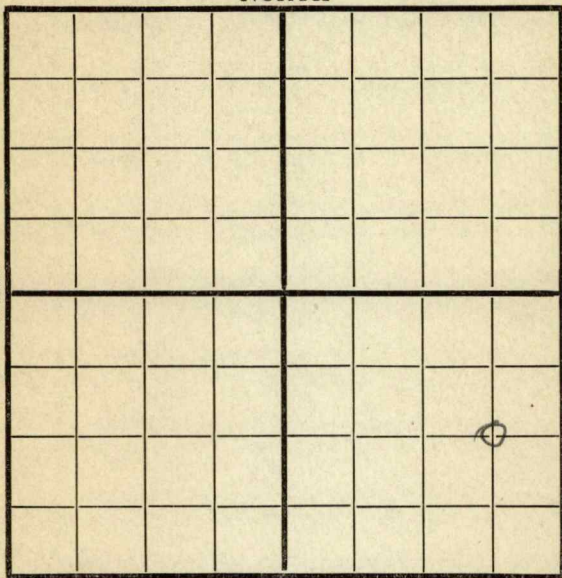

660 E

SOUTH

1320 S

Location _____

Rig up _____

Drilling and Remarks:

D. D @1610

RECORD

Cased _____ in., _____ ft.

Sand _____

Gas _____

Oil _____

Total Depth _____

PRODUCTION

1st 24 hrs. Nat. _____

1st 24 hrs. after shot _____

Gas _____ Cu. Ft.

Dry Hole _____

Abandoned _____

Date

6/28

191

9Cy h Scout


Map No. K9 Sec. 9 Twp. 28 R. 12Well No. 1 MorganVictor & Seymour Company

Contractor

NORTH

WEST

EAST

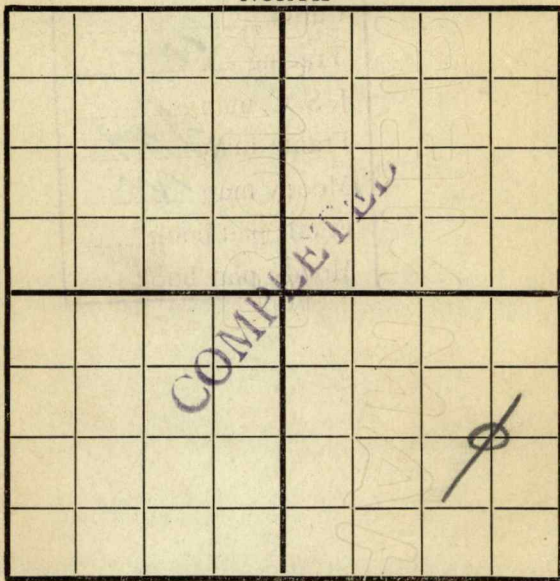

SOUTH

660 E1320 S

Location _____

Rig up _____

Drilling and Remarks:

RECORD

Cased _____ in., _____ ft.

Sand _____

Gas _____

Oil _____

Total Depth _____

PRODUCTION

1st 24 hrs. Nat. _____

1st 24 hrs. after shot _____

Gas _____ Cu. Ft.

Dry Hole 1610

Abandoned _____

Date

7/4 1919Cyle Scout