

KANSAS


Greenwood

Form 51—5M—7-40—Palace

Section 10 Township 28 Range 12-E


Well No. #1 Morton

Company S. Huffman et al

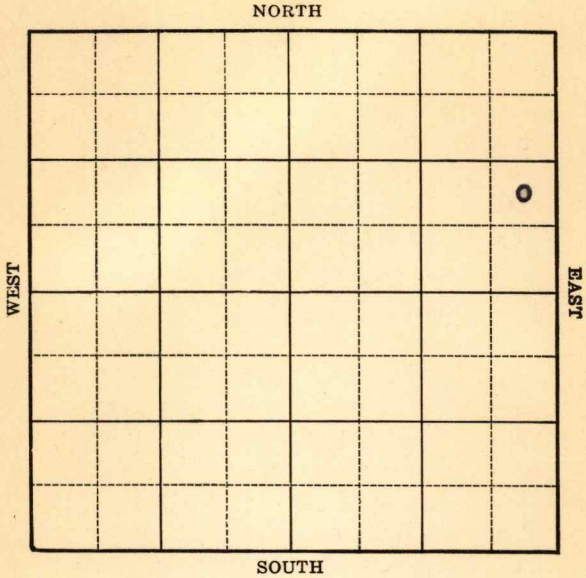

Sec. 10 Twp. 28 R. 12 -EWell No. #1 Morton FarmS. Huffman et al Company

(Misc.)

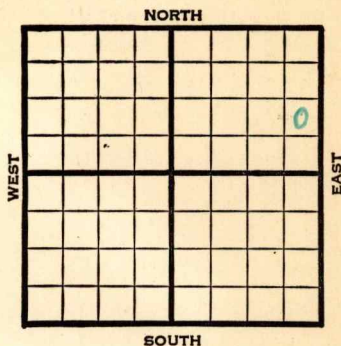 Ft. from N. Line990 Ft. from S. Line330 Ft. from E. Line Ft. from W. Line

1941

REPORT

1/8

Machine.

Spud 50'

1/15

Spud 65'

T.D. 65'

ABANDONED

Map No. 9 Sec. 10 Twp. 28 R. 12EWell No. 1 MortonS. Huffman etal

Company

Contractor

FIRST REPORT

NE SE NE

 Ft. from N. Line990 Ft. from S. Line330 Ft. from E. Line Ft. from W. Line

SECTION PLAT

			o

MISCELLANEOUS

Location Rig up

Drilling and Remarks:

Machine

Spud 50'

RECORD

Cased in., ft.Sand Gas Oil Total Depth

PRODUCTION

1st 24 hrs. Nat. 1st 24 hrs. after shot Gas Cu. Ft.Dry Hole Abandoned

Date

JAN 8 1941

19

S. J. LEWIS Scout

Map No. 9 Sec. 10 Twp. 28 R. 12EWell No. 1 MortonS. Huffman et al

Company

Contractor

ABANDONED

NE SE NE

SECTION PLAT

			a

 Ft. from N. Line990 Ft. from S. Line330 Ft. from E. Line Ft. from W. Line

MISCELLANEOUS

Location Rig up

Drilling and Remarks:

Spud 65'

RECORD

Cased in., ft.Sand Gas Oil Total Depth 65

PRODUCTION

1st 24 hrs. Nat. 1st 24 hrs. after shot Gas Cu. Ft.Dry Hole Abandoned

Date

JAN 15 1941 19

S. J. LEWIS

Scout