

KANSAS


FORM 51 5M 4-41 PETROL

Greenwood

Section 17 Township 28 Range 12 -E


Well No. #1 Crawford

Company C.T. Welch

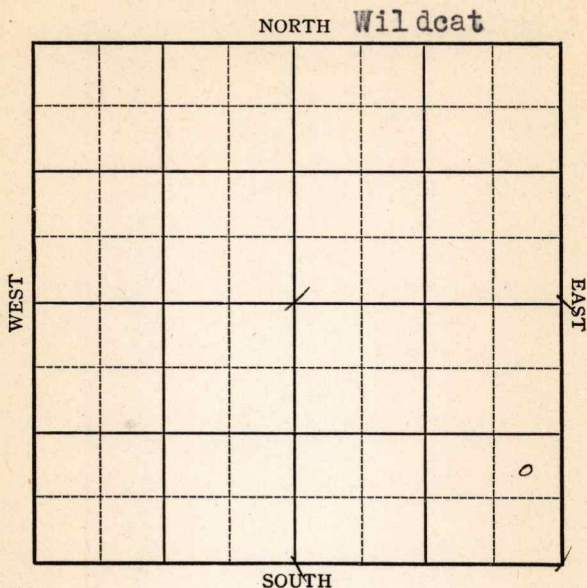

Sec. 17 Twp. 28 R. 12-EWell No. #1 Crawford FarmC. T. Welch Company

(Wildcat)

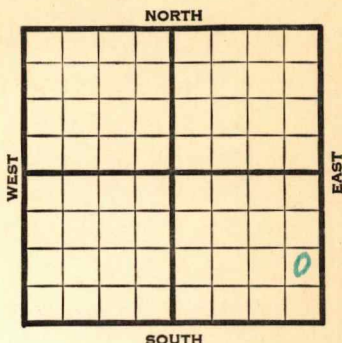 Ft. from N. Line990 Ft. from S. Line330 Ft. from E. Line Ft. from W. Line

1941

REPORT

7/23 10" 7' 8" 328' Drlg. 563

7/31 Lansing 551' Drlg. 660'

8/7 KC 890' 6" @ 890' Drlg. 905'

8/15 U.R. 6" 1020 Sho O & G 1020 -30
T.D. 1030 SD

8/20 K.C. 890'

T.D. 1098'

H.F.W.

ABANDONED

Map No. 9 Sec. 17 Twp. 28 R. 12E

Well No. 1 Crawford

C. T. Welch Company

FIRST REPORT Contractor

NE SE SE

 Ft. from N. Line


990 Ft. from S. Line

330 Ft. from E. Line

 Ft. from W. Line

WILDCAT

SECTION PLAT

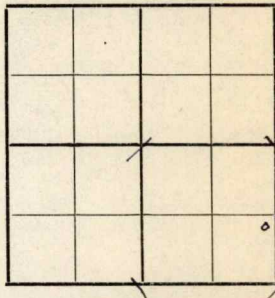

Location

Rig up

Drilling and Remarks:

10" - 7'

8" - 328

Drlg. 563

RECORD

Cased in., ft.

Sand

Gas

Oil

Total Depth

PRODUCTION

1st 24 hrs. Nat.

1st 24 hrs. after shot

Gas Cu. Ft.

Dry Hole

Abandoned

Date

JUL 23 1941

19

S. J. LEWIS

Scout

Map No. 9 Sec. 17 Twp. 28 R. 12EWell No. 1 CrawfordC. T. Welch CompanyABANDONED Contractor

NE SE SE

 Ft. from N. Line990 Ft. from S. Line330 Ft. from E. Line Ft. from W. Line

SECTION PLAT

			0

WILDCAT

Location Rig up

Drilling and Remarks:

KC 890.NAW.

RECORD

Cased in., ft.Sand Gas Oil Total Depth 1095

PRODUCTION

1st 24 hrs. Nat. 1st 24 hrs. after shot Gas Cu. Ft.Dry Hole Abandoned

Date

AUG 20 1941 19 S. J. LEWIS Scout