

Map No. _____ Sec. 25 Twp. 28 R. 12Well No. 10 line OLINE Farm

Company

NORTH

WEST

EAST

SOUTH

Location 9/2Rig Up 19/6

Drilling Remarks

Drilling Remarks

9/30 - Rigging up10-7-10/14-10/21-10/28-11/4-11/11-11/18-11/25-12/2-12/9-100-12/23-270-12/30-SL-1/6-1/13-800-1/20-

RECORD

Cased _____ in. _____ Ft.

Sand _____

Gas _____

Oil _____

Total Depth _____

PRODUCTION

1st 24 hrs. Nat. _____

1st 24 hrs. after shot _____

Gas _____ Cu. Ft.

Dry Hole _____

Abandoned _____

Greenwood

Map No. _____ Sec. 25 Twp. 28 R. 12
 Well No. 1 Oline Farm
F L Beam Company

NORTH

		0					

WEST

EAST

SOUTH

Location ✓
 Rig Up _____
 Drilling and remarks _____

RECORD

Cased _____ in. _____ Ft.
 Sand _____
 Gas _____
 Oil _____
 Total Depth _____

PRODUCTION

1st 24 hrs. Nat. _____
 1st 24 hrs. after shot _____
 Gas _____ Cu. Ft.
 Dry Hole _____
 Abandoned _____

Date

9/2, 1916


E. H. H. H.

Scout

Map No. Elk Sec. 25 Twp. 28 R. 12
 Well No. 1 Oline Farm _____
F. L. Beann Company _____

NORTH

WEST

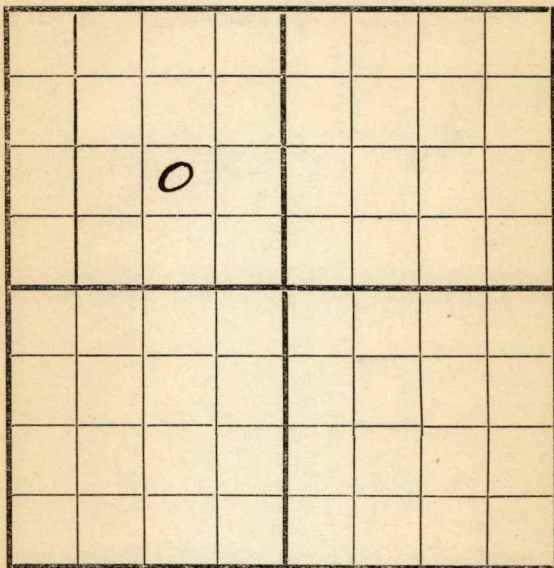

EAST

SOUTH

Location ✓

Rig Up _____

Drilling and remarks _____

RECORD

Cased _____ in. _____ Ft.

Sand _____

Gas _____

Oil _____

Total Depth _____

PRODUCTION

1st 24 hrs. Nat. _____

1st 24 hrs. after shot _____

Gas _____ Cu. Ft.

Dry Hole _____

Abandoned _____


Date

9/9, 1916E. F. West Scout

Elk

Map No. _____ Sec. 25 Twp. 28 R. 12
Well No. 1 Oline Farm
Pioneer O + G Company

NORTH

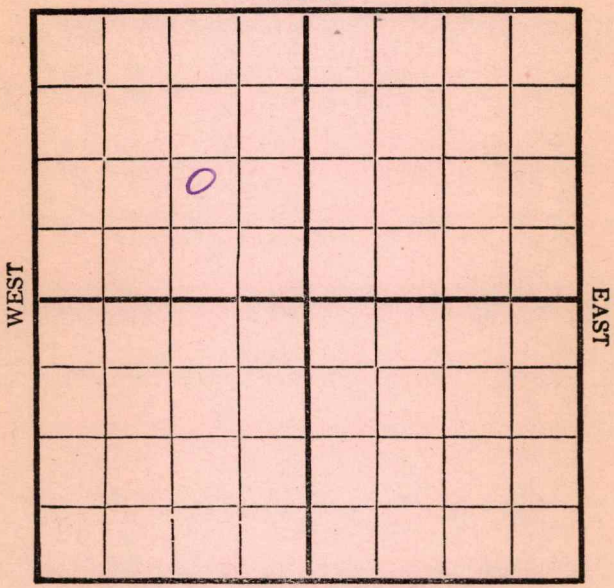

SOUTH

Location _____

Rig Up ✓ _____

Drilling and remarks

tool on ground

RECORD

Cased _____ in. _____ Ft.

Sand _____

Gas _____

Oil _____

Total Depth _____

PRODUCTION

1st 24 hrs. Nat. _____

First 24 hrs. after shot _____

Gas _____ Cu. Ft.

Dry Hole _____

Abandoned _____

Date

9/11/16, 1916

6 Everett

Scout

Map No. 66K Sec. 25 Twp. 28 R. 12
 Well No. 1 Oline Farm
Pioneer Oil & Gas Company

NORTH

WEST

EAST

SOUTH

Location _____
 Rig Up _____
 Drilling and remarks _____

Rigging up.

RECORD

Cased _____ in. _____ Ft.
 Sand _____
 Gas _____
 Oil _____
 Total Depth _____

PRODUCTION

1st 24 hrs. Nat. _____
 First 24 hrs. after shot _____
 Gas _____ Cu. Ft.
 Dry Hole _____
 Abandoned _____

Date

9/23, 191 6

E. J. Hewitt

Scout

Map No. _____ Sec. 25 Twp. 28 R. 12
 Well No. 1 Oline Farm
Pioneer Prod. Company

NORTH

WEST

EAST

SOUTH

Location _____

Rig Up _____

Drilling and remarks

Rigging up

RECORD

Cased _____ in. _____ Ft.

Sand _____

Gas _____

Oil _____

Total Depth _____

PRODUCTION

1st 24 hrs. Nat. _____

1st 24 hrs. after shot _____

Gas _____ Cu. Ft.

Dry Hole _____

Abandoned _____

Date

9/30, 1916E. H. West

Scout

Map No. 25 Sec. 25 Twp. 28 R. 12
 Well No. 1 Oline Farm
Pioneer Prod. Company

NORTH

WEST

EAST

SOUTH

Location _____

Rig Up _____

Drilling and remarks

*Ready to start
waiting for water*

RECORD

Cased _____ in. _____ Ft.

Sand _____

Gas _____

Oil _____

Total Depth _____

PRODUCTION

1st 24 hrs. Nat. _____

1st 24 hrs. after shot _____

Gas _____ Cu. Ft.

Dry Hole _____

Abandoned _____


Date

10/7, 191 *6* *Exwest* Scout

Map No. _____ Sec. 25 Twp. 28 R. 12
 Well No. 1 Oline Farm
Pioneer Prod. Company

NORTH

WEST

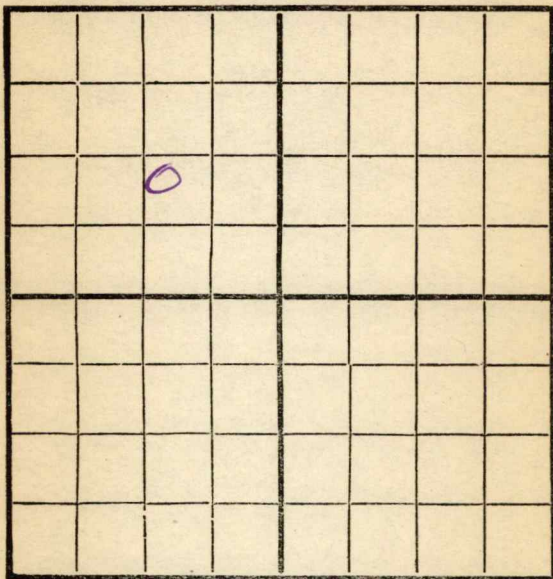

EAST

SOUTH

Location _____
 Rig Up ☒
 Drilling and remarks

Waiting for water

RECORD

Cased _____ in. _____ Ft.
 Sand _____
 Gas _____
 Oil _____
 Total Depth _____

PRODUCTION

1st 24 hrs. Nat. _____
 First 24 hrs. after shot _____
 Gas _____ Cu. Ft.
 Dry Hole _____
 Abandoned _____

Date


10/14

191 *6*

E. H. West

Scout

Map No. **ELK** Sec. **25** Twp. **28** R. **12**
Well No. **1** **Oline** Farm
Pioneer Prod. Company

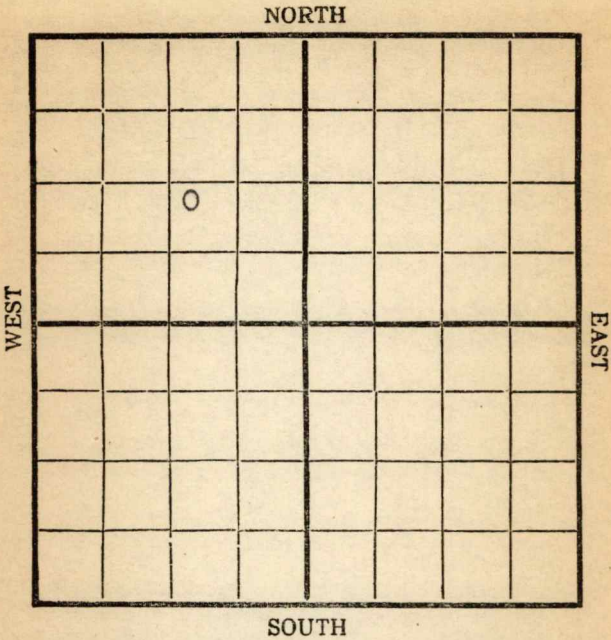


Location _____ Rig Up ☒ _____ Drilling and remarks _____	RECORD Cased _____ in. _____ Ft. Sand _____ Gas _____ Oil _____ Total Depth _____ PRODUCTION 1st 24 hrs. Nat. _____ First 24 hrs. after shot _____ Gas _____ Cu. Ft. Dry Hole _____ Abandoned _____
---	---

Date **OCT 21 1916**
_____, 191____
E. H. WEST Scout

ELK
 Map No. _____ Sec. 25 Twp. 28 R. 12
 Well No. 1 Oline _____ Farm
 _____ Pioneer Prod. _____ Company

NORTH

WEST

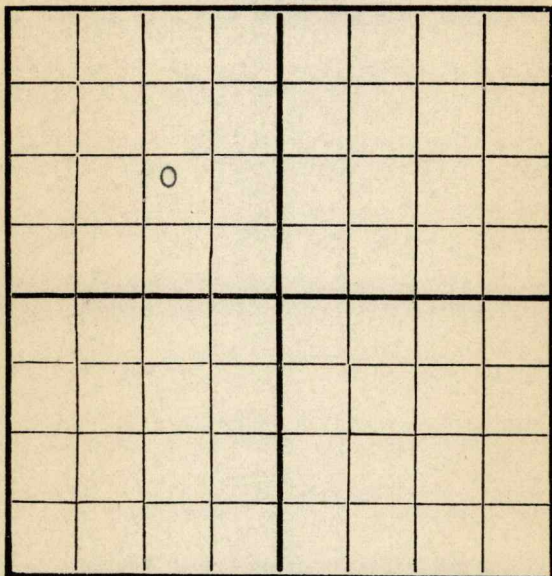

EAST

SOUTH

RECORD

Location _____

Cased _____ in. _____ Ft.

Rig Up _____

Sand _____

Drilling and remarks

Gas _____

All ready to
 start drilling
 but waiting for
 water.

Oil _____

Total Depth _____

PRODUCTION

1st 24 hrs. Nat. _____

1st 24 hrs. after shot _____

Gas _____ Cu. Ft.

Dry Hole _____

Abandoned _____

Date

OCT 28 1916

191


E. H. WEST

Scout

Eek
 Map No. _____ Sec. *25* Twp. *28* R. *12*
 Well No. *1 Oline* Farm _____
Pioneer Prod. Company _____

NORTH

WEST

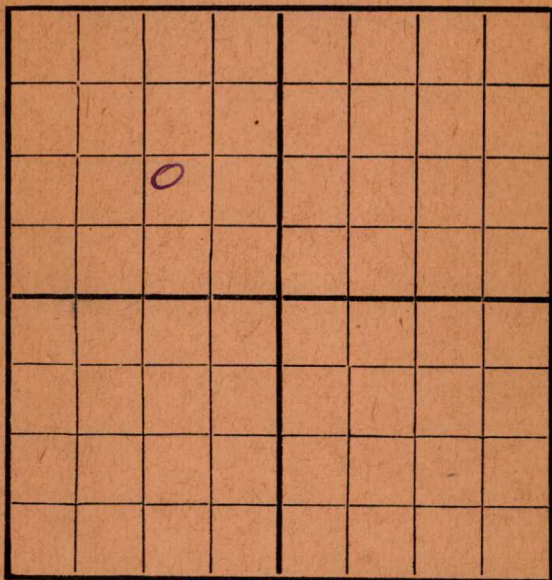

EAST

SOUTH

Location _____

Rig Up ☒ _____

Drilling and remarks _____

waiting water

RECORD

Cased _____ in. _____ Ft.

Sand _____

Gas _____

Oil _____

Total Depth _____

PRODUCTION

1st 24 hrs. Nat. _____

1st 24 hrs. after shot _____

Gas _____ Cu. Ft.

Dry Hole _____

Abandoned _____

Date

11/4


191 *6*

E. H. WEST

Scout

Map No. **ELK** Sec. **25** Twp. **28** R. **12**
 Well No. **1** Oline Farm
 Pioneer Prod Company

NORTH

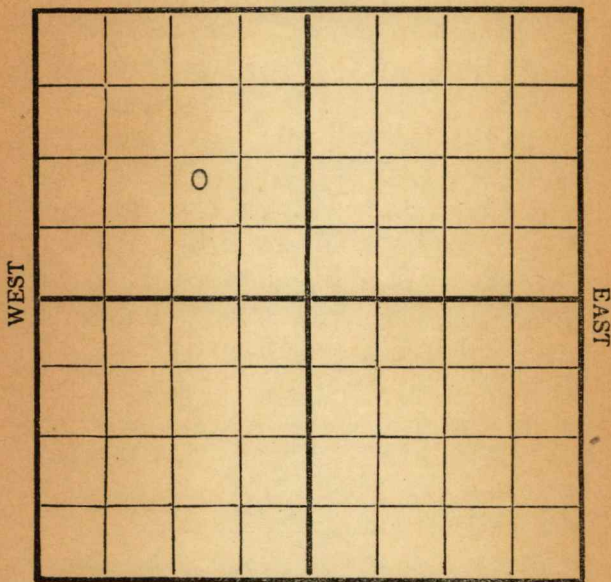

SOUTH

Location _____
 Rig Up **/** _____
 Drilling and remarks _____

RECORD

Cased _____ in. _____ Ft.
 Sand _____
 Gas _____
 Oil _____
 Total Depth _____

PRODUCTION

1st 24 hrs. Nat. _____
 1st 24 hrs. after shot _____
 Gas _____ Cu. Ft.
 Dry Hole _____
 Abandoned _____

Date

NOV 11 1916

191

E. H. WEST Scout

ELKMap No. _____ Sec. 25 Twp. 28 R. 12Well No. 1 Oline _____ Farm_____ Fall River Oil _____ Company

NORTH

WEST	<i>Gomerly - Pioneer Prod Co.</i>								EAST
			0						

SOUTH

Location _____

Rig Up / _____

Drilling and remarks

Waiting for water

RECORD

Cased _____ in. _____ Ft.

Sand _____

Gas _____

Total Depth _____

PRODUCTION

1st 24 hrs. Nat. _____

1st 24 hrs. after shot _____

Gas _____ Cu. Ft.

Dry Hole _____

Abandoned _____

Date

NOV 18 1916

191

E. H. WEST

Scout

ELK

Map No. _____ Sec. 25 Twp. 28 R. 12

Well No. 1 Oline _____ Farm

_____ Fall River Oil Company

NORTH

		0					

WEST

EAST

SOUTH

Location _____

Rig Up ☒ _____

Drilling and remarks

S.D. waiting for water

RECORD

Cased _____ in. _____ Ft.

Sand _____

Gas _____

Oil _____

Total Depth _____

PRODUCTION

1st 24 hrs. Nat. _____

1st 24 hrs. after shot _____

Gas _____ Cu. Ft.

Dry Hole _____

Abandoned _____

Date

NOV 25 1916

_____, 191____ **E. H. WEST** Scout

ELK

Map No. _____ Sec. 25 Twp. 28 R. 12Well No. 1 Oline Farm _____Fall River Oil Company _____

NORTH

		0					

WEST

EAST

SOUTH

Location _____

Rig Up ☒ _____

Drilling and remarks _____

RECORD

Cased _____ in. _____ Ft.

Sand _____

Gas _____

Oil _____

Total Depth _____

PRODUCTION

1st 24 hrs. Nat. _____

1st 24 hrs. after shot _____

Gas _____ Cu. Ft.

Dry Hole _____

Abandoned _____

Date DEC - 2 1916

E. H. WEST

_____, 191_____, _____ Scout


ELK

Map No. _____ Sec. 25 Twp. 28 R. 12Well No. 1 Oline Farm _____Fall River Oil Company _____

NORTH

WEST

EAST

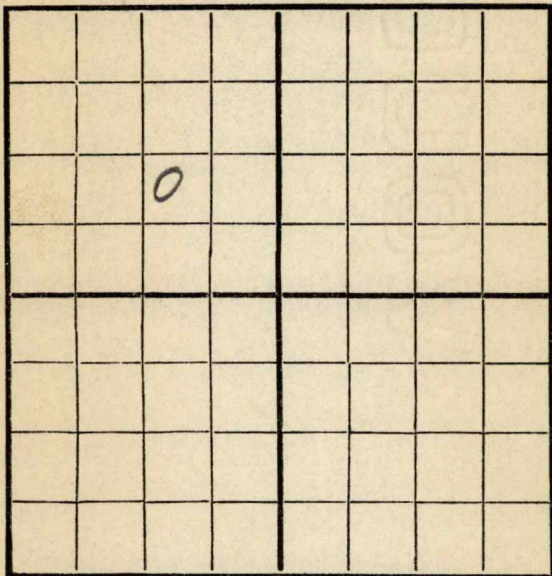

SOUTH

Location _____

Rig Up _____

Drilling and remarks _____

RECORD

Cased _____ in. _____ Ft.

Sand _____

Gas _____

Oil _____

Total Depth _____

PRODUCTION

1st 24 hrs. Nat. _____

1st 24 hrs. after shot _____

Gas _____ Cu. Ft.

Dry Hole _____

Abandoned _____

Date

DEC - 9 1916

191

E. H. WEST

Scout


ELK

Map No. _____ Sec. 25 Twp. 28 R. 12Well No. 1 Oline Farm _____
Fall River Oil Company

NORTH

WEST

EAST

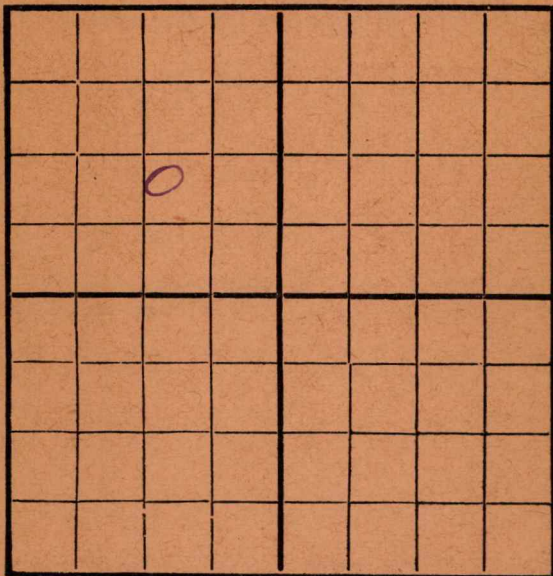

SOUTH

Location _____

Rig Up _____

Drilling and remarks

Spudding

RECORD

Cased _____ in. _____ Ft.

Sand _____

Gas _____

Oil _____

Total Depth _____

PRODUCTION

1st 24 hrs. Nat. _____

1st 24 hrs. after shot _____

Gas _____ Cu. Ft.

Dry Hole _____

Abandoned _____

Date

DEC 16 1916

191


E. H. WEST Scout

ELK

Map No. _____ Sec. 25 Twp. 28 R. 12

Well No. 1 Oline Farm _____
Fall River Oil Company

NORTH

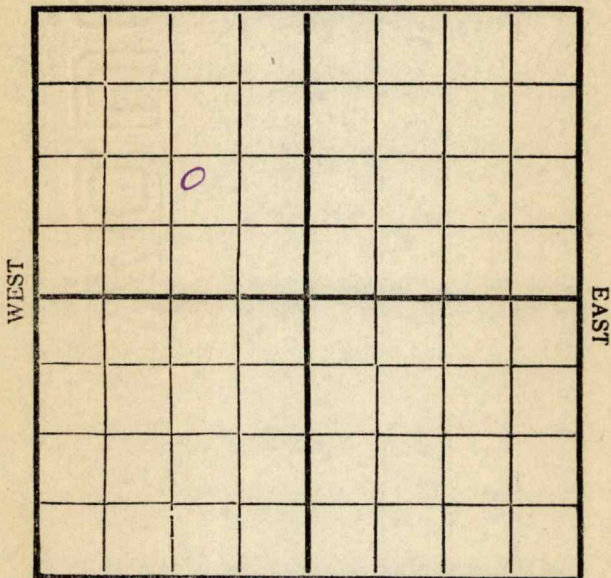

SOUTH

Location _____

Rig Up _____

Drilling and remarks

SA-100

RECORD

Cased _____ in. _____ Ft.

Sand _____

Gas _____

Oil _____

Total Depth _____

PRODUCTION

1st 24 hrs. Nat. _____

1st 24 hrs. after shot _____

Gas _____ Cu. Ft.

Dry Hole _____


Abandoned _____

Date

DEC 23 1916

E. H. WEST

Scout

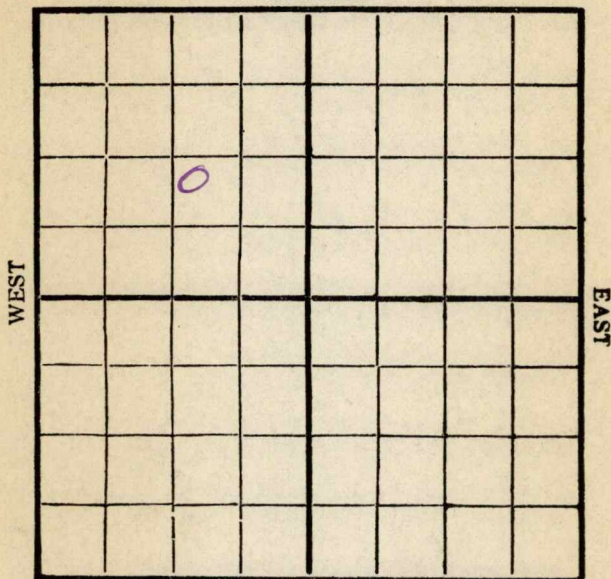ELKMap No. _____ Sec. 25 Twp. 28 R. 12Well No. 1 Oline Farm _____Fall River Company _____**NORTH****SOUTH**

Location _____

Rig Up _____

Drilling and remarks

SD-270**RECORD**

Cased _____ in. _____ Ft.

Sand _____

Gas _____

Oil _____

Total Depth _____

PRODUCTION

1st 24 hrs. Nat. _____

1st 24 hrs. after shot _____

Gas _____ Cu. Ft.

Dry Hole _____

Abandoned _____

Date DEC 30 1916_____, 191____ E. H. WEST Scout

ELK

Map No. _____ Sec. 25 Twp. 28 R. 12

Well No. 1 Oline Farm _____
Fall River Company _____

NORTH

		0					

WEST

EAST

SOUTH

Location _____
 Rig Up _____
 Drilling and remarks _____

RECORD

Cased _____ in. _____ Ft.
 Sand _____
 Gas _____
 Oil _____
 Total Depth _____

PRODUCTION

1st 24 hrs. Nat. _____
 1st 24 hrs. after shot _____
 Gas _____ Cu. Ft.
 Dry Hole _____
 Abandoned _____

Date JAN - 6 1917
 _____, 191_____

E. H. WEST Scout


ELK

Map No. _____ Sec. 25 Twp. 28 R. 12
 Well No. 1 Oline Farm _____
Fall River Company _____

NORTH

WEST

EAST

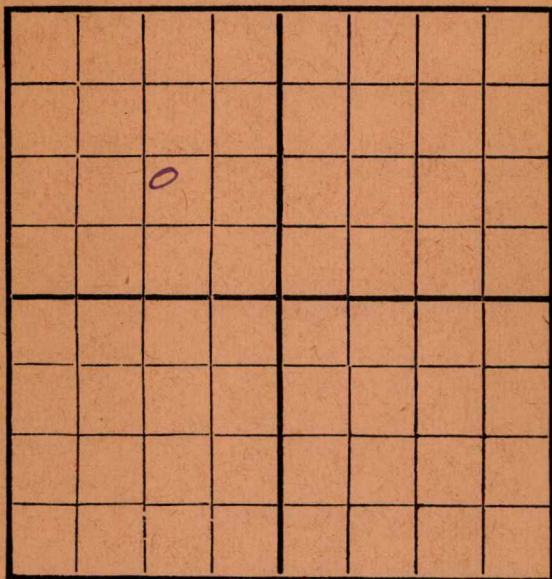

SOUTH

Location _____

Rig Up _____

Drilling and remarks

SD - 270

RECORD

Cased _____ in. _____ Ft.

Sand _____

Gas _____

Oil _____

Total Depth _____

PRODUCTION

1st 24 hrs. Nat. _____

1st 24 hrs. after shot _____

Gas _____ Cu. Ft.

Dry Hole _____

Abandoned _____

Date

JAN 13 1917

191


E. H. WEST

Scout

ELK

Map No. _____ Sec. 25 Twp. 28 R. 12Well No. 1 Oline _____ Farm_____ Tall River Company

NORTH

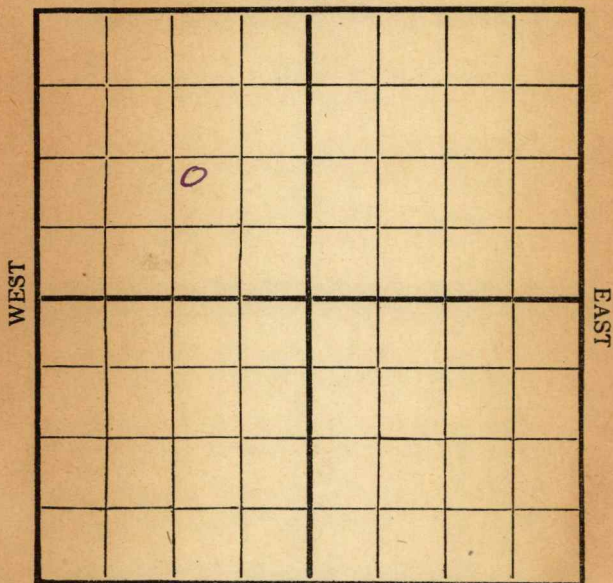

SOUTH

Location _____

Rig Up _____

Drilling and remarks

800

RECORD

Cased _____ in. _____ Ft.

Sand _____

Gas _____

Oil _____

Total Depth _____

PRODUCTION

1st 24 hrs. Nat. _____

1st 24 hrs. after shot _____

Gas _____ Cu. Ft.

Dry Hole _____

Abandoned _____

Date

JAN 20 1917

E. H. WEST

191

Scout

ELK
 Map No. _____ Sec. 25 Twp. 28 R 12
 Well No. 1 Oline Farm _____
Fall River Company _____

NORTH

		0					

SOUTH

Location _____
 Rig Up _____
 Drilling and remarks

A-1034

RECORD

Cased _____ in. _____ Ft.
 Sand _____
 Gas _____
 Oil _____
 Total Depth _____

PRODUCTION

1st 24 hrs. Nat. _____
 1st 24 hrs. after shot _____
 Gas _____ Cu. Ft.
 Dry Hole _____
 Abandoned _____

Date

JAN 27 1917

E. H. WEST

191


Scout

Elk

Map No. _____ Sec. 25 Twp. 28 R. 12Well No. 1 Oline _____ Farm_____ Fall River _____ Company

NORTH

WEST

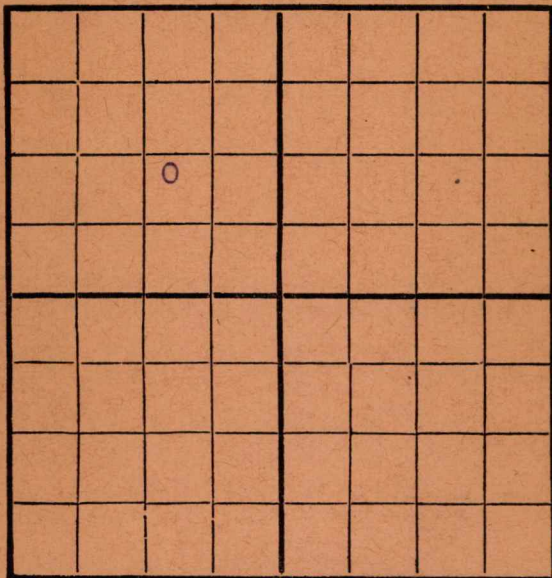

EAST

SOUTH

Location _____

Rig Up _____

Drilling and remarks

1435

RECORD

Cased _____ in. _____ Ft.

Sand _____

Gas _____

Oil _____

Total Depth _____

PRODUCTION

1st 24 hrs. Nat. _____

First 24 hrs. after shot _____

Gas _____ Cu. Ft.

Dry Hole _____

Abandoned _____

Date

FEB 10 1917

191


E. H. WEST

Scout

Map No. _____ Sec. 25 Twp. 28 R. 12Well No. 1 Oline Farm _____
Fall River Oil Company

NORTH

WEST

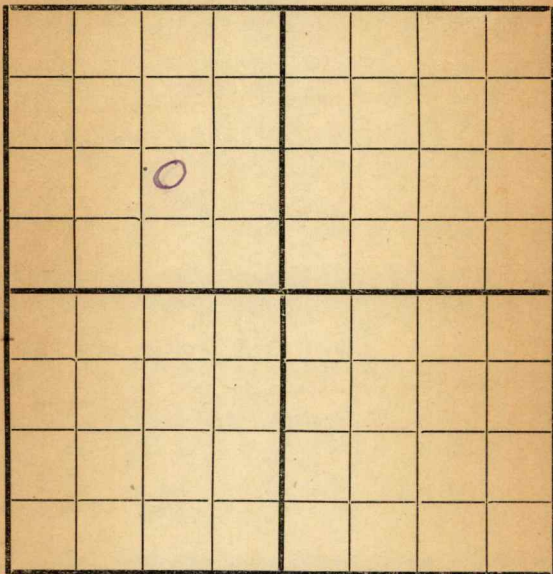

EAST

SOUTH

Location _____

Rig Up _____

Drilling and remarks

D 1435

RECORD

Cased _____ in. _____ Ft.

Sand _____

Gas _____

Oil _____

Total Depth _____

PRODUCTION

1st 24 hrs. Nat. _____

1st 24 hrs. after shot _____

Gas _____ Cu. Ft.

Dry Hole _____

Abandoned _____

Date

FEB 17 1917

C. J. Proctor Scout

Map No. _____ Sec. 25 Twp. 28 R. 12
 Well No. X1 Oline Farm _____
Fall River Oil Company

NORTH

		0					

SOUTH

WEST

EAST

COMPLETED

Location _____
 Rig up _____
 Drilling and Remarks:

D to 1925

Dry & Abandoned

RECORD

Cased _____ in. _____ Ft.
 Sand _____
 Gas _____
 Oil _____
 Total Depth _____

PRODUCTION

1st 24 hrs. Nat. _____
 1st 24 hrs. after shot _____
 Gas _____ Cu. Ft.
 Dry Hole ☒
 Abandoned ☒

Date FEB 24 1917 191 C. J. Crocker Scout