


Map No. **KANSAS** Sec. 28 Twp. 28 R. 12^E
Well No. 1- Omay Farm
Kenton & Morrow Company

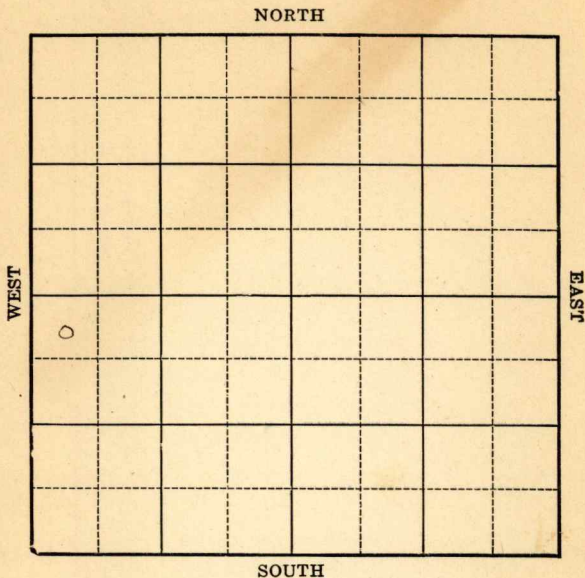

Location _____
Drilling Remarks _____

Rig Up _____
Drilling Remarks _____

RECORD

Cased _____ in. _____ ft.
Sand _____
Gas _____
Oil _____
Total Depth _____

PRODUCTION

1st 24 hrs. Nat. _____
1st 24 hrs. after shot _____
Gas _____ cu. ft.
Dry Hole _____
Abandoned _____

Well No. 1 S May Farm
Denton & Morrow Company

NORTH


400 Ft. from N. Line

Ft. from S. Line

Ft. from E. Line

400 Ft. from W. Line

932

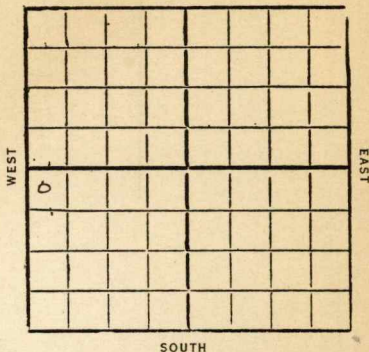

SOUTH

Date _____

REPORT

11/2 Machine

11/9	
------	--

11/16	—
-------	---

11/2.3	—
--------	---

11/30	—
-------	---

11/30	
12/17	—

12	1
17	1

12/14	—
17/21	—

12/28	1700'
1933	

1733
174 Top line 1730

U. TD 1790

Abandoned

Elev

KANSAS

Map No. _____ Sec. 28 Twp. 28 R. 12 ^EWell No. 1 SmayDenton & Morrow Company

Contractor

FIRST REPORTS

400 Ft. from N. Line

_____ Ft. from S. Line

_____ Ft. from E. Line

400 Ft. from W. Line

SECTION PLAT

0			

Location _____

Rig up Machine

Drilling and Remarks:

RECORD

Cased _____ in., _____ ft.

Sand _____

Gas _____

Oil _____

Total Depth _____

PRODUCTION

1st 24 hrs. Nat. _____

1st 24 hrs. after shot _____

Gas _____ Cu. Ft.

Dry Hole _____

Abandoned _____

Date

NOV 2 1932 CHAS. L. SHERWOOD

192

Scout

Eck

E

Map No. **KANSAS** Sec. **28** Twp. **28** R. **12**Well No. **1** **Imay**
Denton & Marnew Company

Contractor

COMPLETED**SECTION PLAT****400** Ft. from N. Line

Ft. from S. Line

Ft. from E. Line

400 Ft. from W. Line

0			

ABANDONED

Location

Rig up

Drilling and Remarks:

Top Line 1730**RECORD**

Cased.....in.,ft.

Sand.....

Gas.....

Oil.....

Total Depth **1790****PRODUCTION**

1st 24 hrs. Nat.....

1st 24 hrs. after shot.....

Gas.....Cu. Ft.

Dry Hole ☒Abandoned ☒

Date

JAN 4 1933 **CHAS. L. SHERWOOD**
192.....Scout