


Elk


KANSAS ✓

Section 28 Township 28 Range 12-E

Well No. 1 "A" Smay

Company Elk Falls O&G

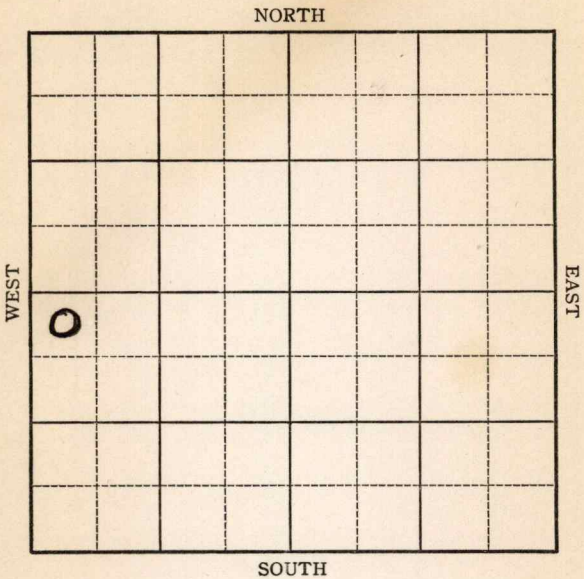

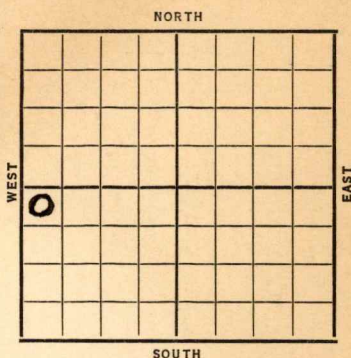Sec. 28 Twp. 28 R. 12-EWell No. #1-"A" Smay FarmElk Falls O & G. Company330 Ft. from N. Line Ft. from S. Line Ft. from E. Line330 Ft. from W. Line**NO-RECORD**

Date

REPORT **O. W. D. D**

1937

8/4 OTD 840'

Rigging up Machine

8/13 5" @ 2114'. S.D.O.

8/20 " " " "

8/28 " " " "

9/3 " " " "

9/10 " " " "

9/17 " " " "

9/22 **K.C. 1128'.**

T.D. 1130'.

1000 acid.

40 bbls.

COMPLETED

KANSAS

Map No. 9 Sec. 28 Twp. 28 R. 12EWell No. 1-A' MayElk Falls O & G

Company

Contractor

Twin Well

SECTION PLAT

330 Ft. from N. Line

_____ Ft. from S. Line

_____ Ft. from E. Line

330 Ft. from W. Line

COMPLETED

QWD 10

0			

Location _____

Rig up _____

Drilling and Remarks:

1000 and40 bbls

RECORD

Cased _____ in., _____ ft.

Sand 15C, 1128

Gas _____

Oil _____

Total Depth 1130

PRODUCTION

1st 24 hrs. Nat. _____

1st 24 hrs. after shot _____

Gas _____ Cu. Ft.

Dry Hole _____

Abandoned _____

Date

SEP 22 1937

19

H. D. Hatfield

Scout

Elk **KANSAS**Map No. 9 Sec. 28 Twp. 28 R. 12EWell No. 1-A" - Smay *Twin well**Elk Falls O & G* Company~~*no record*~~ Contractor

FIRST REPORT

SECTION PLAT

330 Ft. from N. Line

_____ Ft. from S. Line

_____ Ft. from E. Line

330 Ft. from W. Line**NO-RECORD***OWDD*

0			

Location _____

Rig up _____

Drilling and Remarks:

*O.T.O. 840
Rigging up
machine*

RECORD

Cased _____ in., _____ ft.

Sand _____

Gas _____

Oil _____

Total Depth _____

PRODUCTION

1st 24 hrs. Nat. _____

1st 24 hrs. after shot _____

Gas _____ Cu. Ft.

Dry Hole _____

Abandoned _____

Date

AUG 4 - 1937

19

H. D. Hatfield Scout