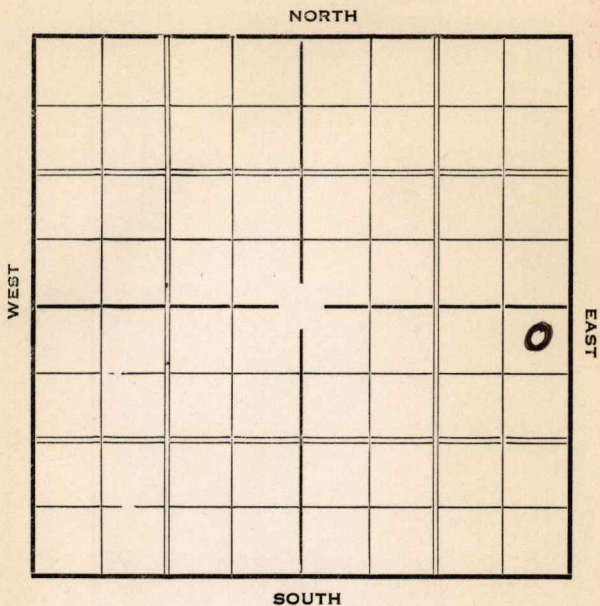


KANSAS

Elk


Section 29 Township 28 Range 12-EWell Number #1 FeeCompany Talbot & Hunter

Sec. 29 Twp. 28 R. 12-EWell No. #1 Fee _____ Farm _____Talbot & Hunter Company330 Ft. from N. Line

_____ Ft. from S. Line

330 Ft. from E. Line

_____ Ft. from W. Line

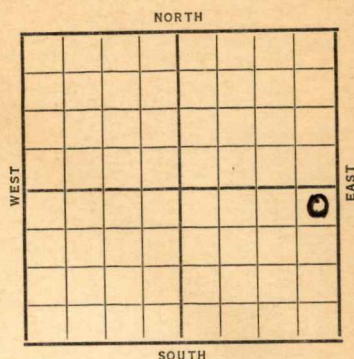

Date	REPORT
1937	
6/30	Machine
7/9	Drlg. 330'.
7/16	12" @ 16'. 10" @ 317'.
	Drlg. 650'.
7/23	8" @ 833'. Drlg. 987'.
7/30	" " " " " "
8/6	K. C. 1132'. Pay 1134-35'.
	T.D. 1138'. 10 oil & 50 water per
	day. S. D. O.
8/13	" "
8/20-	" "
8/28	" "
9/3	" "
9/10	" "
9/17	" "
9/24	250 acid.
10/2	" "
10/8	" "
	OVER

1937

10/13 6" @ 1134'.

K.C. 1132'.

T.D. 1138'.

250 acid.

15 oil & 20 water.

COMPLETED

Elk

KANSAS

Map No. 9 Sec. 29 Twp. 28 R. 12EWell No. 1 FeeTalbott & Hunter

Company

Contractor

COMPLETED

NE SE

330 Ft. from N. Line

Ft. from S. Line

330 Ft. from E. Line

Ft. from W. Line

SECTION PLAT

			0

Location _____

Rig up _____

Drilling and Remarks:

250 and15 oil
20 water

RECORD

Cased 6 in., 1134 ft.Sand K.C. 1132

Gas _____

Oil _____

Total Depth 1138

PRODUCTION

1st 24 hrs. Nat. _____

1st 24 hrs. after shot _____

Gas _____ Cu. Ft.

Dry Hole _____

Abandoned _____

Date

OCT 13 1937

19

H. D. Hatfield Scout

Map No. 9 Sec. 29 Twp. 28 R. 12 ^EWell No. 1-TreeTalbot & Hunter Company

Contractor

FIRST REPORT SECTION PLAT

330 Ft. from N. Line

_____ Ft. from S. Line

330 Ft. from E. Line

_____ Ft. from W. Line

			0

Location _____

Rig up _____

Drilling and Remarks:

machine

RECORD

Cased _____ in., _____ ft.

Sand _____

Gas _____

Oil _____

Total Depth _____

PRODUCTION

1st 24 hrs. Nat. _____

1st 24 hrs. after shot _____

Gas _____ Cu. Ft.

Dry Hole _____

Abandoned _____

Date

JUN 30 1937 19

H. D. Hatfield

Scout