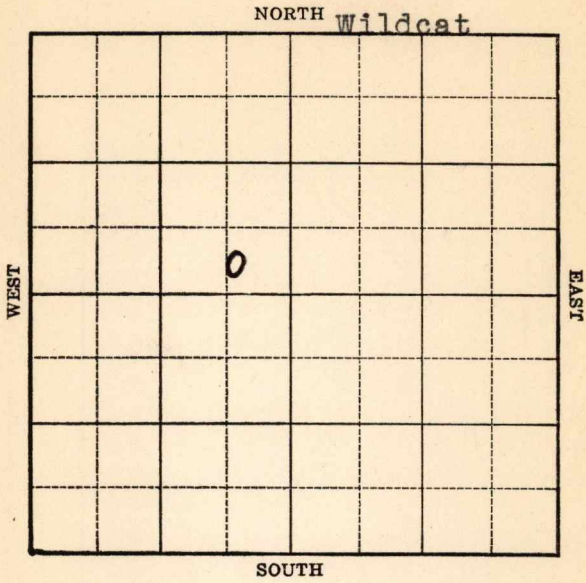


Greenwood

Form 51—5M—11-38—Palace

KANSAS ✓

Section 8 Township 28 Range 13-EWell No. 1 RoushCompany Hancock et al

KANSAS


Greenwood

Sec. 8 Twp. 28 R. 13-EWell No. #1 Roush Farm

Hancock et al

Company

(Wildcat)

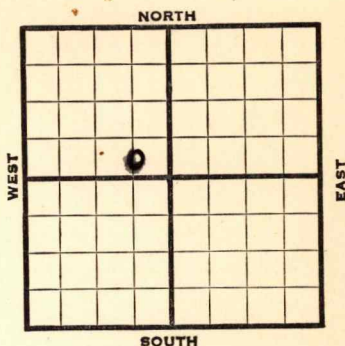0 Ft. from N. Line300 Ft. from S. Line600 Ft. from E. Line Ft. from W. Line

1938	REPORT		
12/21	12" - 198'	10" - 928'	
	Drlg. 1130'		
12/30	"	"	
1939			
1/6	Miss. 1495-1530'		
	T.D. 1530' SD.		
1/13	"	"	"
1/20	"	"	"
1/27	"	"	"
2/3	"	"	"
2/10	"	"	"
2/17	"	"	"
2/23	"	"	"
3/1	Miss. 1495'		
	T. D. 1530'		

ABANDONED

Greenwood **KANSAS**Map No. 8 Sec. 8 Twp. 28 R. 13EWell No. 1 RoushHancock etal

Company

FIRST REPORT

Contractor

Approx.

C S L S E NW

Ft. from N. Line

300 Ft. from S. Line600 Ft. from E. Line

Ft. from W. Line

SECTION PLAT

WILDCAT

Location _____

Rig up _____

Drilling and Remarks:

12" - 198

10" - 928

Dr1g. 1130

RECORD

Cased _____ in., _____ ft.

Sand _____

Gas _____

Oil _____

Total Depth _____

PRODUCTION

1st 24 hrs. Nat. _____

1st 24 hrs. after shot _____

Gas _____ Cu. Ft.

Dry Hole _____

Abandoned _____

Date

DEC 21 1938

19

H. D. Hatfield

Scout

Greenwood

KANSAS

Map No. 8 Sec. 8 Twp. 28 R. 13EWell No. 1 RoushHancock Etal

Company

Contractor

ABANDONED

Approx.

C S L SE NW

 Ft. from N. Line330 Ft. from S. Line600 Ft. from E. Line Ft. from W. Line

SECTION PLAT

	0		

WILDCAT

Location Rig up

Drilling and Remarks:

D & A

RECORD

Cased in., ft.Sand MISS 1495Gas Oil Total Depth 1530

PRODUCTION

1st 24 hrs. Nat. 1st 24 hrs. after shot Gas Cu. Ft.Dry Hole Abandoned

Date

MAR 1 - 1939

19

H. D. Hatfield

Scout