


Form 51-5M-3-35-Mid-West

Map No. **KANSAS** Sec. **9** Twp. **16** R. **12-W**

Well No. **#1 Turgeon** Farm  
**Darby et al** Company

NORTH

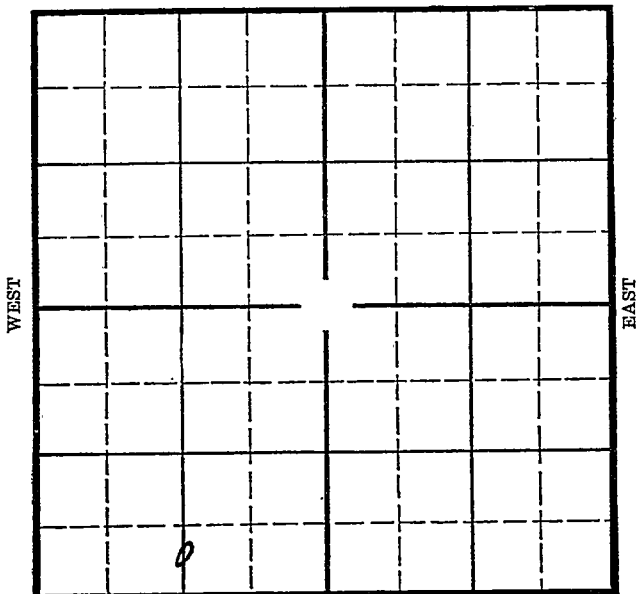

SOUTH

Location \_\_\_\_\_

Drilling Remarks \_\_\_\_\_

\_\_\_\_\_

\_\_\_\_\_

**RECORD**

Cased \_\_\_\_\_ in. \_\_\_\_\_ ft.

Sand \_\_\_\_\_

Gas \_\_\_\_\_

Oil \_\_\_\_\_

Total Depth \_\_\_\_\_

Rig Up \_\_\_\_\_

Drilling Remarks \_\_\_\_\_

\_\_\_\_\_

\_\_\_\_\_

**PRODUCTION**

1st 24 hrs. Nat. \_\_\_\_\_

1st 24 hrs. after shot \_\_\_\_\_

Gas \_\_\_\_\_ cu. ft. \_\_\_\_\_

Dry Hole \_\_\_\_\_

Abandoned \_\_\_\_\_

*Barton*

Map No.            Sec. 9 Twp. 16 R. 12<sup>w</sup>

Well No. 1 - Surgeon Farm             
Derby Hotel Company           


\_\_\_\_\_ Ft. from N. Line

330 Ft. from S. Line

\_\_\_\_\_ Ft. from E. Line

1320 Ft. from W. Line

Elev. 1907

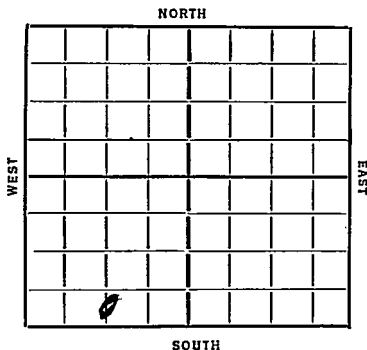

REPORT

~~1936~~  
2/19 B.R.  
2/21 King  
2/28 King  
3/6 Spud  
3/13 Drlg. 390  
3/20 T.D. 407 Cementing crooked hole.  
3/27 Drlg. 397'  
4/2 15" - 480' 12" - 837' Drlg. 884'  
4/10 Drlg. 1750'  
4/16 10" @ 2125'  
4/23 8" @ 2488', Drlg. 2598'  
4/30 Oswald 3080'. T.D. 3115' fishing.  
5/7 --5/14--  
5/21 Gorham 3341' to 49'. 2100' oil. Run tubing.  
5/27/36-Gorham sand 3341-49'  
T.D. 3349'  
Pump 386 bbls in 22 hours.

COMPLETED

KANSAS

Map No. 55 Sec. 9 Twp. 16 R. 12W

Well No. 1-Turgeon

Harby etal Company

Contractor

FIRST REPORTS

SECTION PLAT

..... Ft. from N. Line

330 Ft. from S. Line

..... Ft. from E. Line

1320 Ft. from W. Line


Location.....

Rig up.....

Drilling and Remarks:

BR

RECORD

Cased..... in., ..... ft.

Sand.....

Gas.....

Oil.....

Total Depth.....

PRODUCTION

1st 24 hrs. Nat.....

1st 24 hrs. after shot.....

Gas..... Cu. Ft.

Dry Hole.....

Abandoned.....

Date

ORVAL MANNSCHRECK

2-12-36 192

Scout

Map No. 55 Sec. 9 Twp. 16 R. 12 W

Well No. 1 Turgeon

Harty Dal. Company

Contractor

SECTION PLAT


\_\_\_\_\_ Ft. from N. Line

320 Ft. from S. Line

\_\_\_\_\_ Ft. from E. Line

1320 Ft. from W. Line

COMPLETED

Location \_\_\_\_\_

Rig up \_\_\_\_\_

Drilling and Remarks:

Get hard sand

3341-49

Pump 386 ft

22 hrs.

RECORD

Cased \_\_\_\_\_ in., \_\_\_\_\_ ft.

Sand \_\_\_\_\_

Gas \_\_\_\_\_

Oil \_\_\_\_\_

Total Depth 3349

PRODUCTION

1st 24 hrs. Nat. \_\_\_\_\_

1st 24 hrs. after shot \_\_\_\_\_

Gas \_\_\_\_\_ Cu. Ft.

Dry Hole \_\_\_\_\_

Abandoned \_\_\_\_\_

Date

MAY 7 1936 19

S. J. LEWIS

Scout