


LOG

Map No. Kans Sec. 12 Twp. 28 R. 43

Well No. 1 ~~Wabey~~ John Deyless Farm

C. W. Culp Company

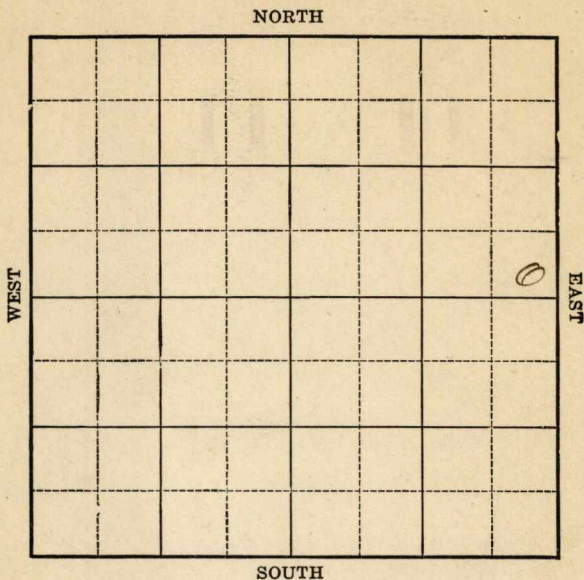

Location \_\_\_\_\_

Drilling Remarks \_\_\_\_\_

\_\_\_\_\_

\_\_\_\_\_

### RECORD

Cased \_\_\_\_\_ in. \_\_\_\_\_ ft.

Sand \_\_\_\_\_

Gas \_\_\_\_\_

Oil \_\_\_\_\_

Total Depth \_\_\_\_\_

Rig Up \_\_\_\_\_

Drilling Remarks \_\_\_\_\_

\_\_\_\_\_

\_\_\_\_\_

### PRODUCTION

1st 24 hrs. Nat. \_\_\_\_\_

1st. 24 hrs. after shot \_\_\_\_\_

Gas \_\_\_\_\_ cu. ft.

Dry Hole \_\_\_\_\_


Abandoned \_\_\_\_\_

Map No. *1100* Sec. *12* Twp. *28* R. *13E*Well No. *1* *Shabby* John Depler Farm*O. W. Culp* Company

Ft. from N. Line

*250'* Ft. from S. Line*250'* Ft. from E. Line

Ft. from W. Line

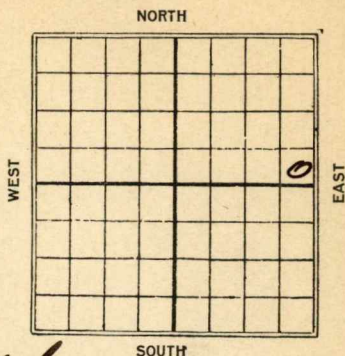*Off set.*Date *1925*

## REPORT

*7/24* set 8" 1407 - Top Line 1425'  
two feet in making  
2 M Dry Gas

*7/28* Drilled 6 inches deeper  
Gas increased to 7974 Gas

*7/31* Running Tubing (Telegram)  
Dry line 785-95' 100,000 gals.  
Spaced 25' 1138-58' gauged  
552,000 gals. Braden loaded. 325  
Lb R.P.

*7. L. 1425-2 1/2 feet in. gauged*  
*7. 332,000 feet of gals. shut*  
*m. 400 lb. R.P.*

*8/7* \_\_\_\_\_

*8/14* \_\_\_\_\_

*8/25* Water broke in around 10"  
Pulled 8 + 10" csg set  
10" with Packers & wire set 6 5/8"  
about 1100 feet with 10" Packers  
Trying to shut off water. (2nd)

8/27 same sand record,  
water broke in @ 785  
pulled 7" + 10", reamed  
10" Csg. Deeper set 10" @ 800'  
with Bottom hole packer  
mudding 10" Will set 6 5/8  
with 10" packer in  
Aswego Lime. + mud  
between, 6 5/8 + 10"

9/8- 10" set @ 800 6 5/8" set bottom hole  
" Perforation, mudded between  
6" + 10" Csg Run 2" Tubing  
+ hanging 3 feet off bottom  
water coming from sand  
59M Gas thru 6" Csg (zel)

9/11 same sand record  
pulled 7" + 10" reamed 10"  
10' Deeper set 10" @ 800'  
with bottom hole packer  
298' of 8" set @ 1412 which  
they could not pull  
6 5/8 Csg. set on bottom with  
11 ft perforation, mudded  
between 6 5/8 + 10" Run 2"  
tubing with a 2" Craig  
Automatic flow  
hanging 3' off bottom  
making est. 2 1/2 M Gas +  
Lots of water thro Tubing  
water coming from sand  
and making est 4 to 5 M Gas  
dry thro. 6" Csg. 420 lbs  
Rock pressure

|        |        |              |
|--------|--------|--------------|
| 9/16 — | 10/1 — | 10/6 —       |
| 9/24 — | 10/8 — | 10/29 11/6 — |


Map No. Kansas Sec. 12 Twp. 28 R. 13  
 Well No. 1 John Depler Farm  
O. W. Culp Company

\_\_\_\_\_ Ft. from N. Line

250 Ft. from S. Line

250 Ft. from E. Line

\_\_\_\_\_ Ft. from W. Line

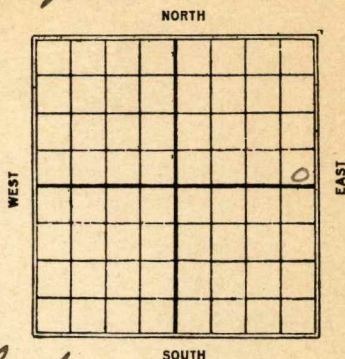

*Offset*

Date

REPORT

12/3 1925  
Sand 1425-1427 1/2  
7 1/3 m Gas Lots  
of water

Map No. Map Sec. 12 Twp. 28 R. 13  
 Well No. 1 Mahly  
O. W. Culp Company

Contractor

## FIRST REPORTS

## SECTION PLAT

|  |  |  |   |
|--|--|--|---|
|  |  |  |   |
|  |  |  |   |
|  |  |  | 0 |
|  |  |  |   |
|  |  |  |   |

Ft. from N. Line

250 Ft. from S. Line

250 Ft. from E. Line

Ft. from W. Line

"OFFSET"

Location

Rig up

Drilling and Remarks:

Set 8" 1407  
 Tap line 1425-  
 2 feet in, making  
 2 million dry  
 gals, L. Heng.

Date

## RECORD

Cased \_\_\_\_\_ in., \_\_\_\_\_ ft.

Sand \_\_\_\_\_

Gas \_\_\_\_\_

Oil \_\_\_\_\_

Total Depth \_\_\_\_\_

## PRODUCTION

1st 24 hrs. Nat. \_\_\_\_\_

1st 24 hrs. after shot \_\_\_\_\_

Gas \_\_\_\_\_ Cu. Ft.

Dry Hole \_\_\_\_\_

Abandoned \_\_\_\_\_

JUL 24 1925

CHAS. L. SHERWOOD

Scout

Map No. KANSAS Sec. 12 Twp. 28 R. 13

Well No. 1 John Sepbr

O. W. Culp Company

Contractor

# SECTION PLAT

\_\_\_\_\_ Ft. from N. Line

750 Ft. from S. Line

750 Ft. from E. Line

\_\_\_\_\_ Ft. from W. Line

## CORRECTION

|  |  |  |  |
|--|--|--|--|
|  |  |  |  |
|  |  |  |  |
|  |  |  |  |
|  |  |  |  |
|  |  |  |  |

Location \_\_\_\_\_

Rig up \_\_\_\_\_

Drilling and Remarks:

chg from  
ran to above

## RECORD

Cased \_\_\_\_\_ in., \_\_\_\_\_ ft.

Sand \_\_\_\_\_

Gas \_\_\_\_\_

Oil \_\_\_\_\_

Total Depth \_\_\_\_\_

## PRODUCTION

1st 24 hrs. Nat. \_\_\_\_\_

1st 24 hrs. after shot \_\_\_\_\_

Gas \_\_\_\_\_ Cu. Ft.

Dry Hole \_\_\_\_\_

Abandoned \_\_\_\_\_

Date

OCT 22 1925

\_\_\_\_\_ 192 \_\_\_\_\_ Scout

CHAS. L. SHERWOOD

WILSON Co

Map No. KANSAS Sec. 12 Twp. 28 R. 13Well No. 1 John SepterO. H. Culp

Company

Contractor

COMPLETED

SECTION PLAT

|  |  |  |   |
|--|--|--|---|
|  |  |  |   |
|  |  |  | o |
|  |  |  |   |
|  |  |  |   |

Ft. from N. Line

250

Ft. from S. Line

250

Ft. from E. Line

Ft. from W. Line

"OFFSET"

Location top line

Rig up

Drilling and Remarks:

Aquifer 25 1138-58'  
 (552,000 gal) 325 lb. R.P.

420 lb Rock Pressure

lots of water.

## RECORD

Cased \_\_\_\_\_ in., \_\_\_\_\_ ft.

Sand 14 25-14 27 1/2

Gas \_\_\_\_\_

Oil \_\_\_\_\_

Total Depth 14 27 1/2

## PRODUCTION

1st 24 hrs. Nat. \_\_\_\_\_

1st 24 hrs. after shot \_\_\_\_\_

Gas 7.332.000 Cu. Ft.

Dry Hole \_\_\_\_\_

Abandoned \_\_\_\_\_

Date

DEC 3 1925

192

CHAS. L. SHERWOOD

Scout