




Map No. **KANSAS** Sec. 2 Twp. 29 R. 1E

Well No. 1-Manaman Farm

M. R. Buck et al Company

NORTH

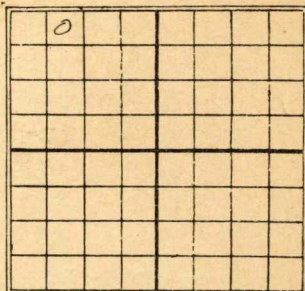

330 Ft. from N. Line

\_\_\_\_\_ Ft. from S. Line

\_\_\_\_\_ Ft. from E. Line

990 Ft. from W. Line

1930

Date

REPORT

Date	REPORT
9/17	Rig
9/24	—
10/1	—
10/8	—
10/15	—
10/22	—
10/29	—
11/5	—
11/12	—
11/19	—
11/25	—
12/3	—
12/10	Ran up
12/17	Put down
12/23	—
12/30	—
1931	—
1/7	—
1/14	—
1/21	—
1/28	—
2/4	Spud

2/11 dreg 865  
 2/18- SD 1200'  
 2/25 —  
 3/4 —  
 3/11- Dreg 1230'  
 3/18- 12 1/2" - 1215  
 3/25- dreg 1630'  
 " 2070'  
 4/11- SD 2225'  
 4/8- HFW 2260  
 sety 10" - 2301  
 4/15- Sand 2295 - 2370'  
 HFW 2310 - 40  
 SD 2340'  
 4/22 —  
 4/29 —  
 5/6 —  
 5/13 —  
 5/20 —  
 5/27 —  
 6/3 —  
 6/10 —  
 6/17 —  
 6/24- 8" - 2442  
 HFW 2675  
 dreg 2790'  
 7/1- 6" - 2843  
 HFW at 2865  
 dreg 2870'  
 7/8 " 2900'  
 7/15- VIR 6" - 2890'  
 6" - 3080'  
 7/22- SD 3225'



*Sedgewick*

Map No. **KANSAS** Sec. 2 Twp. 29 R. 15

Well No. 1 M<sup>c</sup>Manawan

M. R. Buck & Dal Company

Contractor

**SECTION PLAT**

o			

300 Ft. from N. Line

\_\_\_\_\_ Ft. from S. Line

\_\_\_\_\_ Ft. from E. Line

990 Ft. from W. Line

**FIRST REPORTS**

Location \_\_\_\_\_

Rig up \_\_\_\_\_

Drilling and Remarks:

*Rig*

**RECORD**

Cased \_\_\_\_\_ in., \_\_\_\_\_ ft.

Sand \_\_\_\_\_

Gas \_\_\_\_\_

Oil \_\_\_\_\_

Total Depth \_\_\_\_\_

**PRODUCTION**

1st 24 hrs. Nat. \_\_\_\_\_

1st 24 hrs. after shot \_\_\_\_\_

Gas \_\_\_\_\_ Cu. Ft.

Dry Hole \_\_\_\_\_

Abandoned \_\_\_\_\_

Date

**SEP 17 1930**

**S. J. LEWIS** Scout

*Beighwick*

Map No. **KANSAS** Sec. *2* Twp. *29* R. *1* <sup>E</sup>

Well No. *1 McManamaw*

*M. R. Buck et al* Company

Contractor

**COMPLETE**

SECTION PLAT

*330* Ft. from N. Line

..... Ft. from S. Line

..... Ft. from E. Line

*990* Ft. from W. Line

<i>0</i>			

**ABANDONED**

Location.....

Rig up.....

Drilling and Remarks:

*Top Wilcox 3535*  
*NFW 3560-70*

*Top Sili 3575*

RECORD

Cased.....in., .....ft.

Sand.....

Gas.....

Oil.....

Total Depth *3608*

PRODUCTION

1st 24 hrs. Nat.....

1st 24 hrs. after shot.....

Gas.....Cu. Ft.

Dry Hole *✓*

Abandoned *✓*

Date

**AUG 5 1931**

192 **CHAS. L. SHERWOOD** Scout