




Map No. Kansas Sec. 37 Twp. 25 R. 13Well No. 5 Sowden FarmC & C Leasing Co Company720  
11  
500 Ft. from N. Line

Ft. from S. Line

720  
11  
500 Ft. from E. Line

Ft. from W. Line

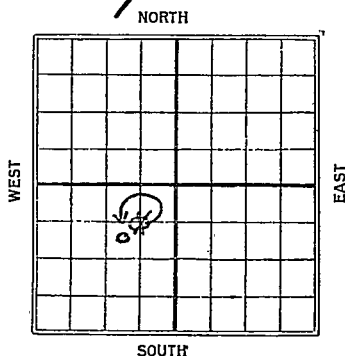

C.

Date	REPORT
1925	
5/8	machine
5/29	Set 6" 1570 show 0 & b. Drlg 1601' 1/2 M gas. show of oil.
6/4	Top Line 1570 set 6" Csg Dly 1621 Sdy Line 1/2 M Gas 53 feet oil in hole shot 80 gts 300 ft oil in hole S.D. to Tuesday (Tel)
6/5	Top Line 1570 set 6" Csg drilled to 1621 Still in Sdy line show 1/2 M Gas & 50 ft oil in hole net 80 gts & Bridged C.O. at 1621 T.D. 31 Gravity
6/19	Top line 1570-set 6" T.D. 1621 in sandy line pumped 10 bbls 1st day, 10 bbls 2nd day Est 1/2 M gas, will try to complete for gas well

6/26 - Top line 1570' set 6"  
1621 in sandy lime, shot  
80 gts pump 10 blbls 1st  
day. 10 blbls 2nd day  
making  $\frac{1}{4}$  M gas S.D.

7/3. S.D. 1621

7/10 T.L. 1570' 1621 in sdy. lime  
80 gts - 5 blbls sho.  $\frac{1}{4}$  M gas  
S.D. will set packer

7/17 - S.D. 1621 TD

7/24 Top L. 1570 - J.D. 1621'  
in sandy lime shot  
80 gts. making  $\frac{1}{2}$  M Gas  
and will pump 10 blbls

Oil.

7/31 —————

8/7 —————

8/14 —————

8/20 —————

8/27 Top Line 1570'  
sand 1570 - 1621' J.D.  
 $\frac{1}{2}$  M Gas + 10 blbls oil  
shot 80 gts.

Map No. 1 1/2 Sec. 31 Twp. 25 R. 13

Well No. 5 Howden

C & C Leasing Co Company

Contractor

SECTION PLAT

660 Ft. from N. Line

\_\_\_\_\_ Ft. from S. Line

660 Ft. from E. Line

\_\_\_\_\_ Ft. from W. Line

	o		

FIRST REPORTS

Location \_\_\_\_\_

Rig up Machine

Drilling and Remarks:

RECORD

Cased \_\_\_\_\_ in., \_\_\_\_\_ ft.

Sand \_\_\_\_\_

Gas \_\_\_\_\_

Oil \_\_\_\_\_

Total Depth \_\_\_\_\_

PRODUCTION

1st 24 hrs. Nat. \_\_\_\_\_

1st 24 hrs. after shot \_\_\_\_\_

Gas \_\_\_\_\_ Cu. Ft.

Dry Hole \_\_\_\_\_

Abandoned \_\_\_\_\_

Date

MAY 8 1925

192

CHAS. L. SHERWOOD  
Scout

Map No. 1/4 Sec 31 Twp. 25 R. 13

Well No. 5

McCleskey Co

Company

Contractor

SECTION PLAT

	50		

720 Ft. from N. Line

\_\_\_\_\_ Ft. from S. Line

720 Ft. from E. Line

\_\_\_\_\_ Ft. from W. Line

CORRECTION

Location \_\_\_\_\_

Rig up \_\_\_\_\_

Drilling and Remarks:

Machine

only 250'

CORRECTION

RECORD

Cased \_\_\_\_\_ in., \_\_\_\_\_ ft.

Sand \_\_\_\_\_

Gas \_\_\_\_\_

Oil \_\_\_\_\_

Total Depth \_\_\_\_\_

PRODUCTION

1st 24 hrs. Nat. \_\_\_\_\_

1st 24 hrs. after shot \_\_\_\_\_

Gas \_\_\_\_\_ Cu. Ft.

Dry Hole \_\_\_\_\_

Abandoned \_\_\_\_\_

Date

**MAY 15 1925**

192 **CHAS. L. SHERWOOD** Scout

*Galbreath & Co*

Map No. *no map* KANSAS Sec. *31* Twp. *25* R. *13*

Well No. *5* *Howards*

*elle Leasing Co* Company

Contractor

COMPLETED

SECTION PLAT

*720* Ft. from N. Line

\_\_\_\_\_ Ft. from S. Line

*720* Ft. from E. Line

\_\_\_\_\_ Ft. from W. Line

		6	

Location \_\_\_\_\_

Rig up \_\_\_\_\_

Drilling and Remarks:

*Tap line 1570  
1/2 million gals.  
9 10 bks oil  
shot 80 gals 161721*

RECORD

Cased \_\_\_\_\_ in., \_\_\_\_\_ ft.

Sand *1570-1621*

Gas \_\_\_\_\_

Oil \_\_\_\_\_

Total Depth *1621*

PRODUCTION

1st 24 hrs. Nat. \_\_\_\_\_

1st 24 hrs. after shot \_\_\_\_\_

Gas *1/2 M* Cu. Ft.

Dry Hole \_\_\_\_\_

Abandoned \_\_\_\_\_

Date

AUG 27 1925

CHAS. L. SHERWOOD

192 \_\_\_\_\_ Scout