


Map No. Range 31 Sec. 25 Twp. 25 R. 13
Well No. 4 Sunder Farm
C. & C. Leasing Company

NORTH

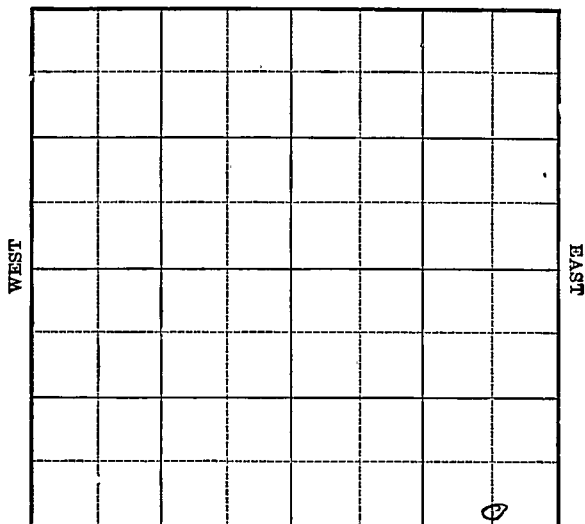

SOUTH

Location _____

Drilling Remarks

Rig Up_____

Drilling Remarks

RECORD

Cased_____in. _____ft.

Sand

Gas

Oil

Total Depth_____

PRODUCTION

1st 24 hrs. Nat.-----

1st. 24 hrs. after shot_____

Gas _____ cu. ft.

Dry Hole

Abandoned _____

Map No. _____ Sec. 31 Twp. 25 R. 13


Well No. 4 Sowder Farm
C & C. Leasing Company

_____ Ft. from N. Line

200 Ft. from S. Line

400 Ft. from E. Line

_____ Ft. from W. Line

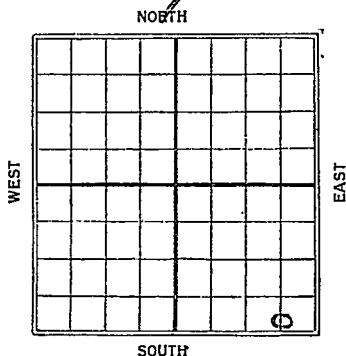

Date

1925
5/8

REPORT

1st & Comp
D. + G. 1640

Map No. 14th Sec. 31 Twp. 25 R. 13Well No. 4 SawderC & C Leasing Co Company

FIRST REPORTS Contractor

COMPLETED

Ft. from N. Line

200 Ft. from S. Line400 Ft. from E. Line

Ft. from W. Line

ABANDONED

SECTION PLAT

			0

Location

Rig up

Drilling and Remarks:

Show on 1610-152. D, 1640'Dry & abandoned

RECORD

Cased _____ in., _____ ft.

Sand _____

Gas _____

Oil _____

Total Depth 1640'

PRODUCTION

1st 24 hrs. Nat. _____

1st 24 hrs. after shot _____

Gas _____ Cu. Ft.

Dry Hole ☒Abandoned ☒

Date

MAY 8 1925

192

CHAS. L. SHERWOOD

Scout