


Section 14 Township 29 Range 1E

Well No. #1 Laughmiller

Company E. H. Adair

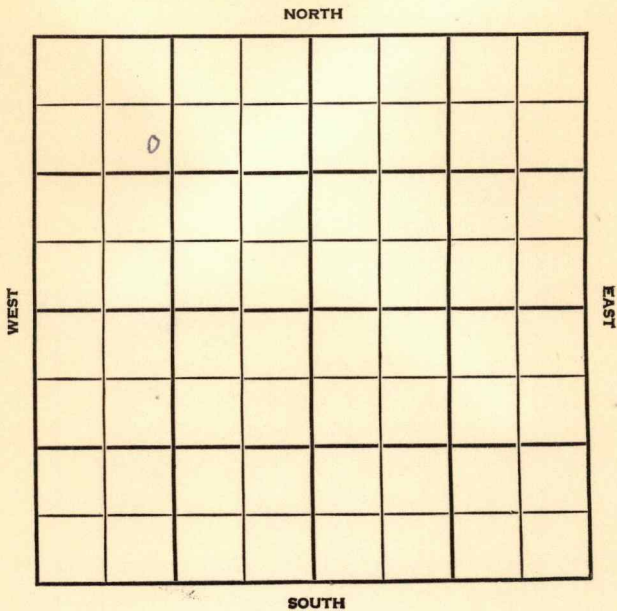

Sedgwick

KANSAS

|      |      |    |
|------|------|----|
| SEC. | TWP. | R. |
| 4    | 29   | 1E |

WELL NO.

1 Laughmiller

FARM

COMPANY

E. H. Adair

CONTRACTOR

Gladys

990

Ft. from N. Line

Ft. from S. Line

Ft. from E. Line

830

Ft. from W. Line

SE NW NW

|       |   |  |  |  |  |  |  |
|-------|---|--|--|--|--|--|--|
| NORTH |   |  |  |  |  |  |  |
| WEST  |   |  |  |  |  |  |  |
|       | 0 |  |  |  |  |  |  |
|       |   |  |  |  |  |  |  |
|       |   |  |  |  |  |  |  |
| SOUTH |   |  |  |  |  |  |  |
| EAST  |   |  |  |  |  |  |  |

|      |           |        |
|------|-----------|--------|
| 1955 | ELEVATION | REPORT |
|------|-----------|--------|

6/15

R U R

7/7

Comm. 6-14-55

8 5/8" @ 176

D&amp;A

Tosp:

Depth

KC.

2652

BKC

2843

Ce. Penn Ch

3159

M. Lm.

3165

TD. 3165

ABANDONED

County Sedgwick Elev. \_\_\_\_\_ Co.  
 Sec. 4 Twp. 29 Rge. 1E  
 Company E. H. Adair  
 Farm Name Laughmiller No. 1

| TOPS   | DEPTH | LOG | DATUM | Loc. in Sec. |
|--------|-------|-----|-------|--------------|
| Anh.   |       |     |       | SE NW NW     |
| Tp.    |       |     |       | 990' NL      |
| H.     |       |     |       | 830' WL      |
| Tr.    |       |     |       | Geol.        |
| Dg.    |       |     |       | Contr.       |
| Bl.    |       |     |       | Pool         |
| L.     |       |     |       | Gladys       |
| K.C.   |       |     |       |              |
| B.K.C. |       |     |       |              |
| Ce.    |       |     |       |              |
| C.     |       |     |       |              |
| M.     |       |     |       |              |
| M.     |       |     |       |              |
| K.     |       |     |       |              |
| Mz.    |       |     |       |              |
| Mq.    |       |     |       |              |
| V.     |       |     |       |              |
| S.     |       |     |       |              |
| S.     |       |     |       |              |
| A.     |       |     |       |              |
| R.     |       |     |       |              |
| Pe.    |       |     |       |              |
| G.     |       |     |       |              |
| TD.    |       |     |       |              |

FIRST REPORT  
 JUN 15 55

Date Comm.

R U R

County Sedgwick Elev. 1E  
Sec. 4 Twp. 29 Rgs. 1E  
Company E. H. Adair  
Farm Name Laughmiller No. 1

| TOPS        | DEPTH | LOG | DATUM | Loc. in Sec. |
|-------------|-------|-----|-------|--------------|
| Anh.        |       |     |       | SE NW NW     |
| Tr.         |       |     |       | 990' NL      |
| Dg.         |       |     |       | 830' WL      |
| Bl.         |       |     |       |              |
| L.          |       |     |       | Geol.        |
| K.C.        | 2652  |     |       | Contr.       |
| B.K.C.      | 2843  |     |       |              |
| Ce. Penn ch | 3159  |     |       |              |
| C.          |       |     |       |              |
| M. Lm       | 3165  |     |       |              |
| M.          |       |     |       | Pool         |
| K.          |       |     |       | Gladys       |
| Mz.         |       |     |       |              |
| Me.         |       |     |       |              |
| V.          |       |     |       |              |
| S.          |       |     |       |              |
| S.          |       |     |       |              |
| A.          |       |     |       |              |
| R.          |       |     |       |              |
| Pe.         |       |     |       |              |
| G.          |       |     |       |              |
| T.D.        | 3195  |     |       |              |

Date Comm. 6-14-55 JUL 6 1955  
8 5/8" @ 176

D & A