


Section 5 Township 29 Range 1E

Well No. #2 Howell

Company Petroleum Inc.

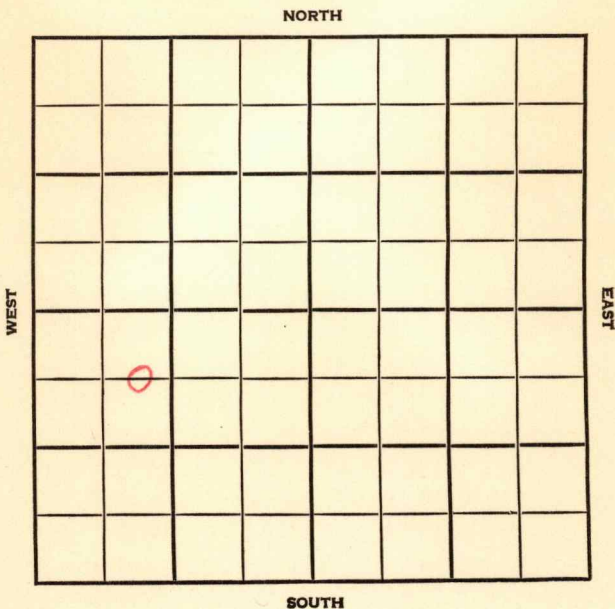

Sedgwick

KANSAS

SEC.	TWP.	R.
5	29	1E

WELL NO. **2 Howell** FARM

COMPANY **Petroleum Inc.**

CONTRACTOR **Garvey**

S. Gladys Pool


660' Ft. from N. Line

_____ Ft. from S. Line

_____ Ft. from E. Line

990' Ft. from W. Line

C E 1/2 NW SW

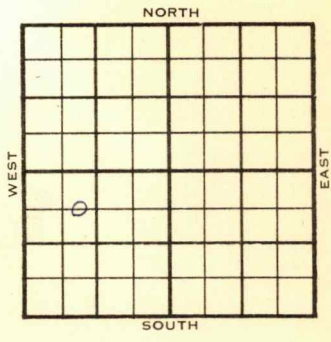

	ELEVATION	REPORT
1955	1266	

6/1 Spud 5-27-55
8" @ 194 w/150
Drlg 2800

6/22 Comm 6-4-55
KC 2666, M ch 3190, M dolo 3194,
S 3605, A 3663, TD 3680
8" @ 202 DST 3190-3202 open 1 hr
Rec 30' mud 560/15" DST 3202-12
open 1 hr Rec 65' o & gcm 640/20"
DST 3213-23 open 1 hr Rec 50' so &
gcm 940/20"
D & A

ABANDONED

County Sedgwick Elev. 1260
 Sec. 5 Twp. 29 Rgs. 1E
 Company Petroleum Inc.
 Farm Name Howell No. 2

TOPS	DEPTH	LOG	DATUM	Loc. in Sec.
Anh.				C E $\frac{1}{2}$ NW SW
Tp.				
H.				
Tr.				
Dg.				
Bl.				
L.				
K.C.	<u>2674</u>		<u>1414</u>	Geol. _____
B.K.C.				Contr. _____
Ce.				
C.				<u>Garvey</u>
M. <u>ch</u>	<u>3193</u>		<u>1933</u>	Pool
M. <u>Dolo</u>	<u>3195</u>		<u>1935</u>	
K.				<u>S. Gladys</u>
Mz.				
Mo.				
V.				
S.				
S.				
A.				
R.				
PE.				
G.				
T.D.	<u>3207</u>			

ABANDONED
 0

Date Comm. 5-27-55 JUN 22 1955
8" @ 194/150 - DST 3195-3207 open 1 hr.
gas in 45 min. Rec. 85' o & gcm
1240/20" 5 $\frac{1}{2}$ " @ 3198 CO to 3207
B/ 7.5 goph .85 gw 4 $\frac{1}{2}$ hr. 500 A
S/ 17 bo 1-bf 90% wtr. S/ 18 go
27 gw PB 3202 1000 A S/ 18 go 36-46
gwph CO to 3207 S/ 2.34 bf DD 3212
S/ 1.17 bf 1/4 oil in 3 hr. DD 3222

D & A