

Section 6 Township 29 Range 1 E

Well No. # 1 Chesney Est.

Company Greenland Drlg.

NORTH

0							

WEST

EAST

SOUTH

Sedgwick KANSAS


SEC. 6 TWP. 29 R. 1E

WELL NO. 1 Chesney Est. FARM

COMPANY Greenland Drlg.

CONTRACTOR Co. Tools

330 Ft. from N. Line
 Ft. from S. Line
 Ft. from E. Line
 330 Ft. from W. Line

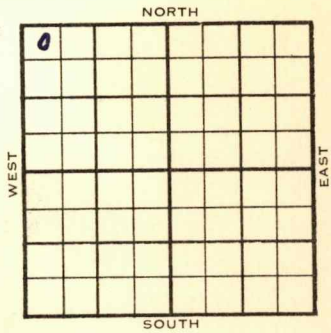

NW NW NW
TITE HOLE

1955 ELEVATION 1292' REPORT

3/16
 4/27

RUR
 Spud 3-14-55 - D&A
 TD 3266'
 8" @ 159'
Loss. 2700', Miss 3227', Miss dol 3242'
 DST 3241-53', opn 1 hr., rec. 55' oil,
 20'mco, 40' hocm, 785#
 TD 3255'
 5" @ 3243'
 DD 3266', 1500A
 FU 1200' fluid 90% wtr.
 3 or 4 bfph 90% wtr.
 D&A

ABANDONED

County Sedgwick State Kansas

Sec. 6 (Blk. Twp.) 29 (Sur. Rge.) 1E Map No.

Operator Greenland Drlg.

Well No. 1 Farm Chesney Est.

Elev. 1292 Location NW NW NW

0				

330 Ft. From N Line NW
330 Ft. From W Line Quarter

1st. Report

Completion APR 27 1955

Remarks

Co. tools

Spudding Date 3-14-55

Drlg. Data D & A TD 3266

8" @ 159 Lans. 2700 Miss. 3227

Miss. dol. 3242 DST 3241-53 open 1 hr.

Rec. 55' oil 20' mco 40' hocm 785#

TD 3255 5" @ 3243 DD 3266 1500 A

FU 1200' fluid 90% wtr.

S/ 3 or 4 bfph 90% wtr.

D & A

FABEN GILSTRAP